


KANSAS Rice

Section 12 Township 20 Range 10W

Well No. 9 Logan-Shoyno

Company D.R. Lauck

Silica Pool
NORTH

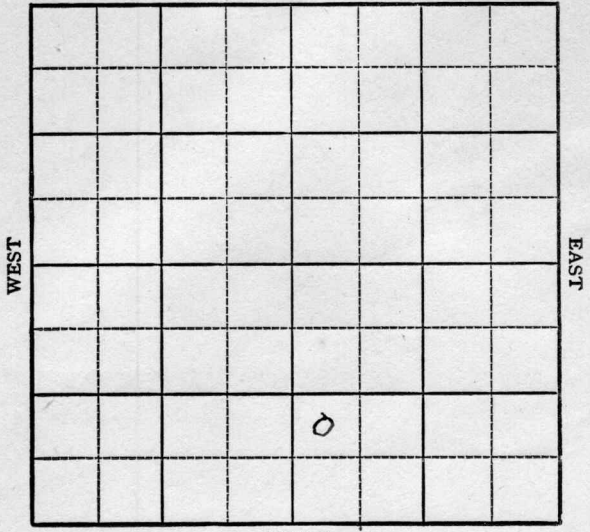

KANSAS Rice

Sec. 12 Twp. 20 R. 10-W ✓

Well No. #9- Logan-Shoyno Farm

D R Lauck Company

Silica


 Ft. from N. Line

990 Ft. from S. Line

 Ft. from E. Line

330 Ft. from W. Line

NW SW SE

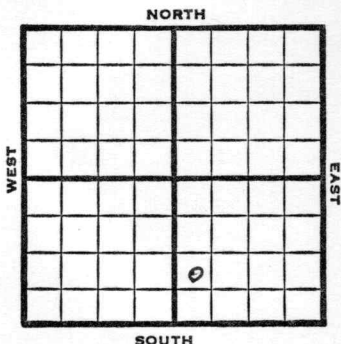

1948

Eli 1767'

REPORT

10/6

8" @ 147'

10/13

Lansing 2993'

Drlg. 3066'

10/19

Arbuckle 3290'

5" @ 3290'

TD 3299'

10/27

TD 3308'

Arb. 3290'

5" @ 3290'

500 acid

Pump 60 oil Pot

42° Gr.

Comp

COMPLETED

Map No. _____ Sec. 12 Twp. 20 R. 10W

Well No. 9 Logan - Shoyno

D. R. Lauck Company

FIRST REPORT Contractor

NW SW SE

SECTION PLAT

_____ Ft. from N. Line

990 Ft. from S. Line

_____ Ft. from E. Line

330 Ft. from W. Line

Rice County

Location _____

Rig up _____

Drilling and Remarks:

8" @ 147

RECORD

Cased _____ in., _____ ft.

Sand _____

Gas _____

Oil _____

Total Depth _____

PRODUCTION

1st 24 hrs. Nat. _____

1st 24 hrs. after shot _____

Gas _____ Cu. Ft.

Dry Hole _____

Abandoned _____

Date

OCT 6 1948

19

S. J. LEWIS

Scout

Kansas

Map No. 46 Sec. 12 Twp. 20 R. 10WWell No. 9 Logan * ShoynoD. R. Lauck

Company

COMPLETE

Contractor

NW SW SE

E11762
SECTION PLAT Ft. from N. Line990 Ft. from S. Line Ft. from E. Line330 Ft. from W. Line

		6	

Rice County

Location Rig up

Drilling and Remarks:

Ar 8290
5" @ 8290
500 acal
Pump 60 oil
P.S.

42 3/4

RECORD

Cased in., ft.Sand Gas Oil Total Depth 8208

PRODUCTION

1st 24 hrs. Nat. 1st 24 hrs. after shot Gas Cu. Ft.Dry Hole Abandoned

Date

OCT 27 1948 19S. J. LEWIS

Scout