


Form 51—5M—11-38—Palace

Rice

Section 13 Township 20 Range 10-W

Well No. #1 E. J. Proffitt

Company Tatlock

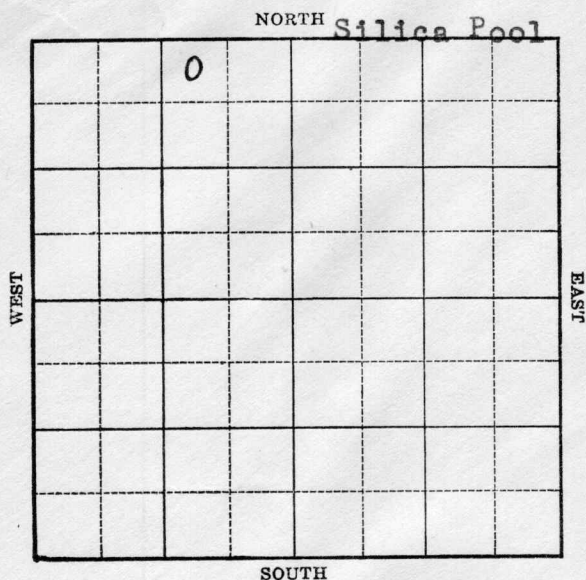


KANSAS

Rice

Sec. 13 Twp. 20 R. 10-WWell No. #1 E. J. Proffitt FarmTatlock Company

(Silica)

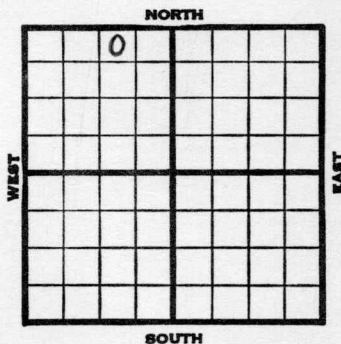330 Ft. from N. Line Ft. from S. Line990 Ft. from E. Line Ft. from W. Line

1939

REPORT

10/4

10" - 153'

Drlg. 982'

10/12

Drlg. 2812'

10/18

Arb. 3336' water.

T.D. 3366'

ABANDONED

Rice

Map No. _____ Sec. 13 Twp. 20 R. 10WWell No. 1 E. J. ProffittTatlock

Company _____

Contractor _____

FIRST REPORT

NW NE NW

330 Ft. from N. Line

_____ Ft. from S. Line

990 Ft. from E. Line

_____ Ft. from W. Line

SECTION PLAT

	0		

SILICA POOL

RECORD

Location _____

Cased _____ in., _____ ft.

Rig up _____

Sand _____

Drilling and Remarks:

Gas _____

10" - 153

Oil _____

Dr1g. 982

Total Depth _____

PRODUCTION

1st 24 hrs. Nat. _____

1st 24 hrs. after shot _____

Gas _____ Cu. Ft.

Dry Hole _____

Abandoned _____

Date

OCT 4 193919S. J. LEWIS

Scout

Rice

KANSAS

Map No. 46 Sec. 13 Twp. 20 R. 10WWell No. 1 E. J. ProffittTatlock

Company

Contractor

ABANDONED

SECTION PLAT

	0		

NW NE NW

330

Ft. from N. Line

Ft. from S. Line

990

Ft. from E. Line

Ft. from W. Line

SILICA POOL

Location _____

RECORD

Cased _____ in., _____ ft.

Sand _____

Gas _____

Oil _____

Total Depth 3366

Rig up _____

Drilling and Remarks:

CR 83336Water.

PRODUCTION

1st 24 hrs. Nat. _____

1st 24 hrs. after shot _____

Gas _____ Cu. Ft.

Dry Hole _____

Abandoned _____

Date

OCT 18 1939 19

S. J. LEWIS

Scout