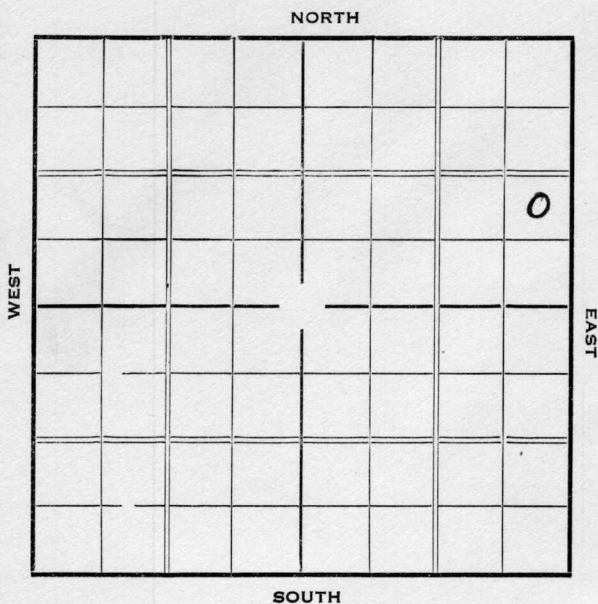


Section 13 Township 20 Range 10WWell Number 1 ^{harp}Company Sacco Oil

Map No. 46 Sec. 13 Twp. 20 R. 10W

Well No. 1 Sharp

Dacco Oil Company

Contractor

SECTION PLAT

			o

_____ Ft. from N. Line

990 Ft. from S. Line

330 Ft. from E. Line

_____ Ft. from W. Line

FIRST REPORT

Location ✓

Rig up _____

Drilling and Remarks:

RECORD

Cased _____ in., _____ ft.

Sand _____

Gas _____

Oil _____

Total Depth _____

PRODUCTION

1st 24 hrs. Nat. _____

1st 24 hrs. after shot _____

Gas _____ Cu. Ft.

Dry Hole _____

Abandoned _____

Date

FEB 3 1937 19

S. J. LEWIS Scout

KANSAS *Rice*Map No. _____ Sec. 13 Twp. 20 R. 10W.Well No. 1 Sharp.Sacco Oil Company

Contractor _____

SECTION PLAT

			o

_____ Ft. from N. Line

990 Ft. from S. Line330 Ft. from E. Line

_____ Ft. from W. Line

ABANDONED

Location _____

Rig up _____

Drilling and Remarks:

Sil 3307.2000 acidWater

RECORD

Cased _____ in., _____ ft.

Sand _____

Gas _____

Oil _____

Total Depth 3342

PRODUCTION

1st 24 hrs. Nat. _____

1st 24 hrs. after shot _____

Gas _____ Cu. Ft.

Dry Hole ☒Abandoned ☒

Date

APR 7 1937

19

S. J. LEWIS

Scout