

KAPCO

Cowley

Section 29 Township 31 Range 5E


Well No. 1 Calvin

Company E. Wakefield

Wilcat
NORTH

WEST

EAST

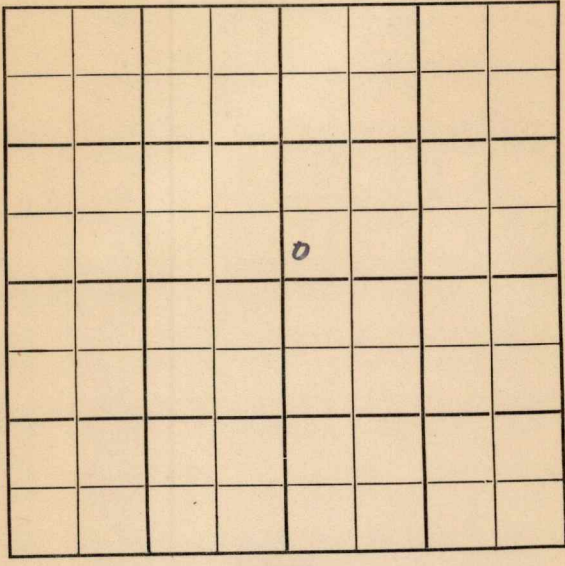

SOUTH

KANSAS

Cowley ✓

Sec. 29 Twp. 31 R. 5E

Well No. 1 Calvin Farm

E. Wakefield

Company


Wildcat

 Ft. from N. Line

330 Ft. from S. Line

 Ft. from E. Line

330 Ft. from W. Line

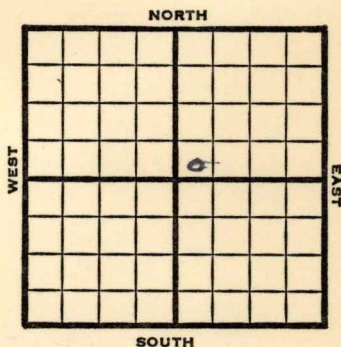

SW NE

1949 **Elev 1271'** REPORT

9/28 8" @ 100'

10/5 TD 2300
7" @ 2298'

10/12 **KC 2340'**
Dr1g 2345'

10/19 "

10/26 "

11/2 TD 2355'
KC 2340'
Aband.

ABANDONED

Map No. _____ Sec. 29 Twp. 31 R. 5E


Well No. 1 Calvin

E. Wakefield Company

Contractor

SW NE

FIRST REPORT
SECTION PLAT

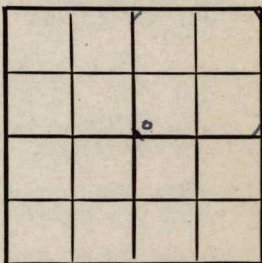

Ft. from N. Line

330 Ft. from S. Line

Ft. from E. Line

330 Ft. from W. Line

Cowley County

Location

Rig up

Drilling and Remarks:

8" @ 100

RECORD

Cased _____ in., _____ ft.

Sand _____

Gas _____

Oil _____

Total Depth _____

PRODUCTION

1st 24 hrs. Nat. _____

1st 24 hrs. after shot _____

Gas _____ Cu. Ft.

Dry Hole _____

Abandoned _____

Date

SEP 28 1949 19

S. J. LEWIS Scout

Map No. _____ Sec. 29 Twp. 31 R. 5E

Well No. 1 Calvin

E. Wakefield Company

ABANDONED Contractor

SW NE

E 11276
SECTION PLAT

_____ Ft. from N. Line

330 Ft. from S. Line

_____ Ft. from E. Line

330 Ft. from W. Line

Cowley County

Location _____

Rig up _____

Drilling and Remarks:

KC 2340

RECORD

Cased _____ in., _____ ft.

Sand _____

Gas _____

Oil _____

Total Depth 2600

PRODUCTION

1st 24 hrs. Nat. _____

1st 24 hrs. after shot _____

Gas _____ Cu. Ft.

Dry Hole _____

Abandoned _____

Date

NOV 2 1949 19

S. J. LEWIS Scout