

Map No. KANSAS Sec. 13 Twp. 20 R. 10^W

Well No. 1-Sharp Farm

John Stark et al Company

L. E. Cress et al

NORTH

WEST

EAST

SOUTH

OWDD

Location _____

Drilling Remarks _____

Rig Up _____

Drilling Remarks _____

RECORD

Cased _____ in. _____ ft.

Sand _____

Gas _____

Oil _____

Total Depth _____

PRODUCTION

1st 24 hrs. Nat. _____

1st 24 hrs. after shot _____

Gas _____ cu. ft.

Dry Hole _____

Abandoned _____

Map No. KANSAS Sec. 13 Twp. 20 R. 10^w
 Well No. 1-Sharp Farm
John Stark et al Company
L.E. Cress et al

NORTH

WEST

EAST

SOUTH

 Ft. from N. Line

330 Ft. from S. Line

330 Ft. from E. Line

1930 Ft. from W. Line

Date

REPORT

12/30 Loc
1931
1/17
1/14 Blky reg
1/21 regm up
1/28
2/4 Dreg 735'
2/11 12"-1332
 dreg 1470'
2/18 " 1920'
2/25 " 2340'
3/4 HFW 2568-70
 UIR 8"
3/11 Dreg 2910'
3/18 show oil & gas 3107-15
 TD 3150' UIR 6"
3/26 Top Calc line 3335
 TD 3336' 6"-3140
 filled up 1000' oil in
 20 minutes
 Now hole full oil
 Draw 47'-Pulling by pipe
 will let set

4/1- T.D. 3336' shut in
4/9- at T.D. 3336 Had
hole full oil & slopping ^{over}
deepened 2 1/2 feet
T.D. 3338 1/2'

Rain baulk and
commenced flowing
steady -
Flowed 6" stream 3/4 hr
and shut in
Est 1500 bbl well.

4/15- T.D. 3338 1/2"
Hole full oil - No test

4/22- ~~Sand~~ ^{Silic} 3333-38 1/2'

T.D. 3338 1/2'
Hole full oil
No test
shut in
Orrup.

1931 OWDD

12/2- Silic 3333-38 1/2

Old T.D. 3338 1/2'
No test

Prep. to deepen

12/9


12/16- Deepened to
T.D. 3341

Pump 50 bbl per hr

12/22- T.D. 3341
pump 1079 bbl 24 hr
10% B.S.

Map No. _____ Sec. 13 Twp. 20 R. 10^W
 Well No. 1-Sharp Farm _____
Dress et al Company _____

NORTH

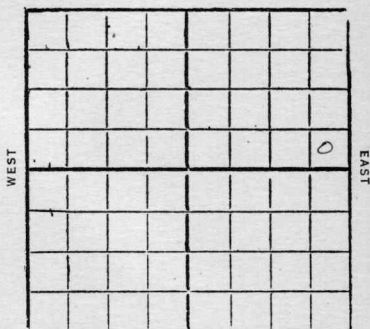

_____ Ft. from N. Line

330 Ft. from S. Line

330 Ft. from E. Line

_____ Ft. from W. Line

SOUTH

Date

REPORT

12/30 Shic 3333-41
T.D. 3341
Pump 1079 bbl 24 hrs
100% water
Comp.

Map No. **KANSAS** Sec. 13 Twp. 20 R. 10 W

Well No. 46 Sharp

John Stock & Co. Company

Contractor

SECTION PLAT

			0

..... Ft. from N. Line

930 Ft. from S. Line

930 Ft. from E. Line

..... Ft. from W. Line

FIRST REPORTS

Location ✓

Rig up

Drilling and Remarks:

RECORD

Cased in., ... ft.

Sand

Gas

Oil

Total Depth

PRODUCTION

1st 24 hrs. Nat.

1st 24 hrs. after shot

Gas Cu. Ft.

Dry Hole

Abandoned

Date

DEC 30 1930

S. J. LEWIS

Scout

Map No. KANSAS Sec. 13 Twp. 20 R. 10 W

Well No. 46 Sharpe

L. E. Cress et al Company

Contractor

SECTION PLAT

 Ft. from N. Line

330 Ft. from S. Line

330 Ft. from E. Line

 Ft. from W. Line

			0

Location

Rig up

Drilling and Remarks:

RECORD

Cased in., ft.

Sand

Gas

Oil

Total Depth

PRODUCTION

1st 24 hrs. Nat.

1st 24 hrs. after shot

Gas Cu. Ft.

Dry Hole

Abandoned

Date

JAN 7 1931 192 S. J. LEWIS Scout

Rice

46 KANSAS

Map No. Sec. 13 Twp. 20 R. 10^W

Well No. 1 Sharpe

L. E. Cress et al Company

Contractor

COMPLETE

SECTION PLAT

			0

Ft. from N. Line

330 Ft. from S. Line

330 Ft. from E. Line

Ft. from W. Line

Location

Rig up

Drilling and Remarks:

Hole full of Oil.

No test.

Shut in.

RECORD

Cased in, ft.

Sand 3333-3338 1/2.

Gas

Oil

Total Depth 3338 1/2.

PRODUCTION

1st 24 hrs. Nat.

1st 24 hrs. after shot

Gas Cu. Ft.

Dry Hole

Abandoned

Date

APR 22 1931

192

CHAS. L. SHERWOOD

Scout

Rice

46 KANSAS Map No. Sec. 13 Twp. 20 R. 10^W

Well No. 1 Sharpe

L. E. Cress & Co Company

Contractor

FIRST REPORTS

Ft. from N. Line

330 Ft. from S. Line

330 Ft. from E. Line

Ft. from W. Line

SECTION PLAT

			o
	OWD		

Location

Rig up

Drilling and Remarks:

Prep to Deepen

RECORD

Cased in, ft.

Sand Sili 3333-38 1/2

Gas No test

Oil

Total Depth

PRODUCTION

1st 24 hrs. Nat.

1st 24 hrs. after shot

Gas Cu. Ft.

Dry Hole

Abandoned

Date

DEC 2 1931

CHAS. L. SHERWOOD

192

Scout

Rice

46 KANSAS

Map No. _____ Sec. 13 Twp. 20 R. 10 ^WWell No. 1 ShaferL E Sress et al Company_____
Contractor

COMPLETED

SECTION PLAT

Ft. from N. Line330 Ft. from S. Line330 Ft. from E. Line_____
Ft. from W. Line

			0

Location _____

Rig up _____

Drilling and Remarks:

Pump 1079 Bl
24 Hours.
10% water

RECORD

Cased _____ in., _____ ft.

Sand Sili 3333-41

Gas _____

Oil _____

Total Depth 3341

PRODUCTION

1st 24 hrs. Nat. _____

1st 24 hrs. after shot _____

Gas _____ Cu. Ft.

Dry Hole _____

Abandoned _____

Date

DEC 30 1931

192

CHAS. L. SHERWOOD

Scout