


Section 28 Township 31 Range 5E

Well No. #1 Sickles

Company Andy Crow

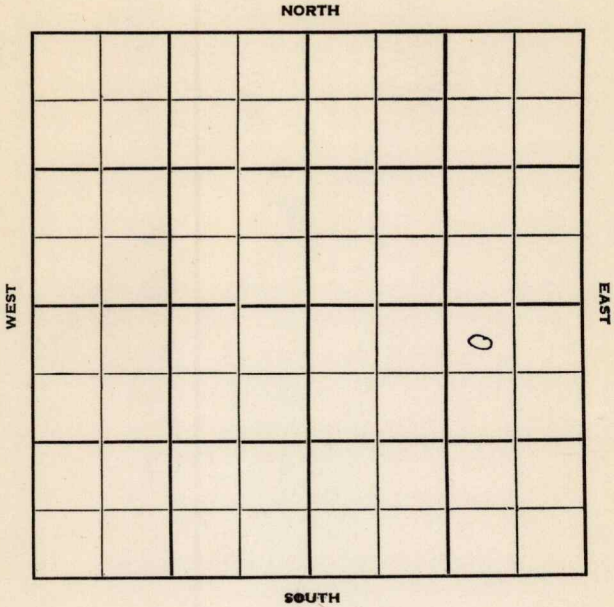

Cowley

KANSAS

Sec. 28 Twp. 31 R. 5E

Well No. #1 Sickles Farm

Andy Crow

Company

Lehman

Contractor


330 Ft. from N. Line

Ft. from S. Line

990 Ft. from E. Line

Ft. from W. Line

NW NE SE

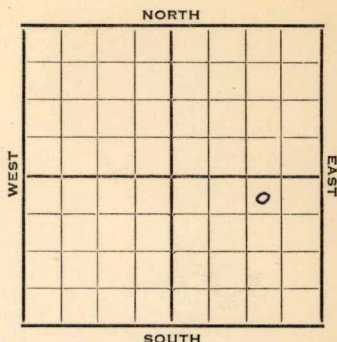

1952

Elev. 1305'

REPORT

3/5

Cable tools RUR

4/23

Spud 3-17-52

D&A TD 2325'

15" @ 250 13" @ 725'

10" @ 1500' 8" @ 1783'

7" @ 2045'

Layton 2300-25' TD HFW D&A


ABANDONED

County **Cowley** State **Kansas**
 Sec. **28** (Blk. **31** (Sur. **5E** Map No.

Operator **Andy Crow**

Well No. **1** Farm **Sickles**

Elev. Location **NW NE SE**

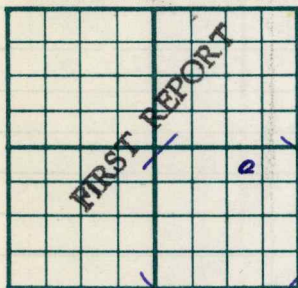

330 Ft. From **N** Line **SE**

990 Ft. From **E** Line Quarter

1st. Report **MAR 5 1952**

Completion

Remarks

Lehman - Contr.

Spudding Date

Drlg. Data

Cable tools RUR


J. G. McGEHEE

County Cowley State Kansas
 Sec. 28 (Blk.) 31 (Sur.) 5E Map No.

Operator Andy Crow

Well No. 1 Farm Sickles

Elev. 1305 Location NW NE SE

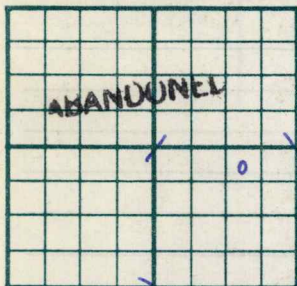

330 Ft. From N Line SE

990 Ft. From E Line Quarter

1st. Report

Completion APR 23 1952

Remarks

Lohman - Contr.

Spudding Date 3-17-52

Drlg. Data D & A TD 2325

15" @ 250 13" @ 725 10" @ 1500

8" @ 1783 7" @ 2045 Layton 2300-25 TD

HFW D & A