


Cowley

~~SW~~ ~~SA~~ ~~SW~~

Section 23 Township 31 Range 4E

Well No. #1 Deichman

Company Kanotex Ref.

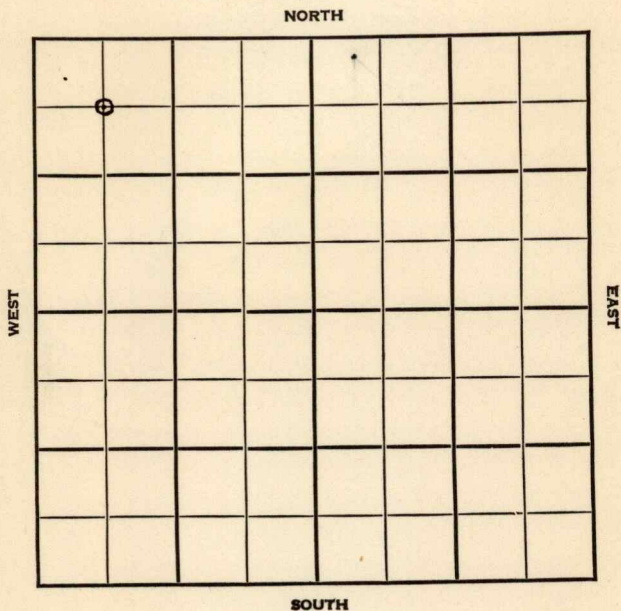

Sec. 23 Twp. 31 R. 4E

Well No. #1 Deichman Farm

Kanotex Ref. Company

Misc.


660 Ft. from N. Line

 Ft. from S. Line

 Ft. from E. Line

660 Ft. from W. Line

C NW NW

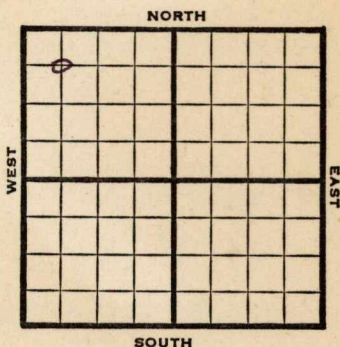

1948

Elev. 1300' REPORT

1/28 Location

2/4 8" @ 103'
Drlg. 1489'

2/11 **Bart. 2983'**
Mississippi 2995'
TD 3026'
5" @ 2983'
RUST

2/18 "

2/25 50 qts. 2994-3026'
Swb. 2 bbls. oil / 7 W PH

3/3 **Bart 2983'**
Miss. 2995'
5" @ 2983'
50 qts
Pump 35 oil / 35 W Pot.
Gr. 400
Total Depth 3026'

COMPLETED

Map No. _____ Sec. 23 Twp. 31 R. 4E

Well No. 1 Deichman

Kanotex Ref. Company

FIRST REPORT Contractor

C NW NW

SECTION PLAT

660 Ft. from N. Line

_____ Ft. from S. Line

_____ Ft. from E. Line

660 Ft. from W. Line

o			

Cowley County

Location X

Rig up _____

Drilling and Remarks:

RECORD

Cased _____ in., _____ ft.

Sand _____

Gas _____

Oil _____

Total Depth _____

PRODUCTION

1st 24 hrs. Nat. _____

1st 24 hrs. after shot _____

Gas _____ Cu. Ft.

Dry Hole _____

Abandoned _____

Date

JAN 28 1948 19

S. J. LEWIS Scout

Map No. 2 Sec. 23 Twp. 31 R. 4E

Well No. 1 Deichman

Kanotex: Ref. _____ Company _____

COMPLETE

Contractor _____

C NW NW

E11300
SECTION PLAT

660 Ft. from N. Line

_____ Ft. from S. Line

_____ Ft. from E. Line

660 Ft. from W. Line

<i>6</i>			

Cowley County

Location _____

Rig up _____

Drilling and Remarks:

Bar 2985

Miss 2985

5' 02983

5096

Pump oil 135 W

AD

4024

RECORD

Cased _____ in., _____ ft.

Sand _____

Gas _____

Oil ☒

Total Depth *8026*

PRODUCTION

1st 24 hrs. Nat. _____

1st 24 hrs. after shot _____

Gas _____ Cu. Ft.

Dry Hole _____

Abandoned _____

Date

MAR 3 1948 19

S. J. LEWIS

Scout