

KANSAS

Rice


Section 15 Township 20 Range 10WWell No. 2 LinkeCompany A.J. Stormfeltz

Raymond

NORTH

WEST

EAST

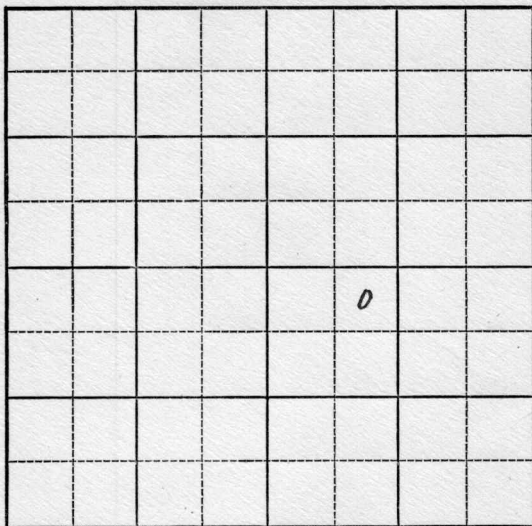

SOUTH

KANSAS Rice

Sec. 15 Twp. 20 R. 10W

Well No. #2 Linke Farm

A. J. Stormfeltz Company

Raymond Pool (Brunson, Cont.) NORTH


330' Ft. from N. Line

_____ Ft. from S. Line

_____ Ft. from E. Line

990' Ft. from W. Line

NE NW SE

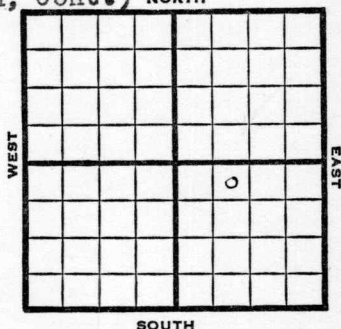

1949 Elev 1829' REPORT

5/25 10" @ 153'
Anhy. 580'
Drlg. 1250'

6/1 Indian Cave 2338'-54'
TD 2354'
7" @ 2338'

6/7 "

6/15 "

6/21 "

6/29 TD 2554'
Indian Cave 2338'
Aband.

ABANDONED

Map No. _____ Sec. 15 Twp. 20 R. 10W

Well No. 2 Linke

A. J. Stormfeltz Company

Brunson Contractor

NE NW SE

FIRST REPORT
SECTION PLAT

330 Ft. from N. Line

		o	

_____ Ft. from S. Line

_____ Ft. from E. Line

990 Ft. from W. Line

Rice County

Location _____

Rig up _____

Drilling and Remarks:

10" @ 153

Anhy 580

drlg. 1250

RECORD

Cased _____ in., _____ ft.

Sand _____

Gas _____

Oil _____

Total Depth _____

PRODUCTION

1st 24 hrs. Nat. _____

1st 24 hrs. after shot _____

Gas _____ Cu. Ft.

Dry Hole _____

Abandoned _____

Date

MAY 25 1949

19

S. J. LEWIS

Scout

Map No. X 46 Sec. 15 Twp. 20 R. 10W

Well No. 2 Linke

A. J. Stormfeltz Company

ABANDONED

Contractor

NE NW SE


E 1/8 29
SECTION PLAT

330 Ft. from N. Line

_____ Ft. from S. Line

_____ Ft. from E. Line

990 Ft. from W. Line

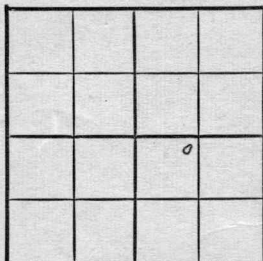

Rice County

Location _____

Rig up _____

Drilling and Remarks:

Indian Cave
233 ft.

RECORD

Cased _____ in., _____ ft.

Sand _____

Gas _____

Oil _____

Total Depth 235 ft.

PRODUCTION

1st 24 hrs. Nat. _____

1st 24 hrs. after shot _____

Gas _____ Cu. Ft.

Dry Hole _____

Abandoned _____

Date

JUN 29 1949 19

S. J. LEWIS

Scout