


Rice county

Section 14 Township 20 Range 10-W

Well No. #1, Noland

Company C. H. Hyde etal

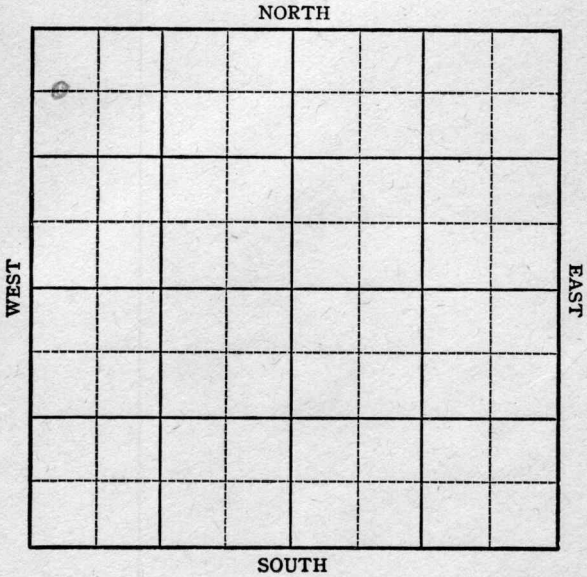

Sec. 14 Twp. 20 R. 10W

Well No. 1 Noland Farm

C. H. Hyde ETAL Company


Silica Pool

660 Ft. from N. Line

Ft. from S. Line

Ft. from E. Line

330 Ft. from W. Line

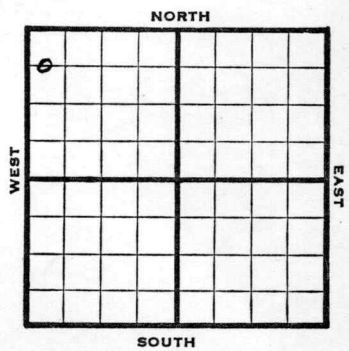

C W L NW NW

1947

Elev. 1809

REPORT

1/2

Surface Hole

1/8

Topeka 2632'  
Lans 3066'  
stain 3134-37,  
3146-50 TD  
5" @ 3140', RUST

1/15

TD 3152'  
HFW PB 3140

1/21

Drlg 3255'

2/12

Lans 3066  
5" @ 3140  
TD 3277'

ABANDONED

KANSAS  
Kansas

Silica Pool

Map No. 40 Sec. 14 Twp. 20 R. 10W

Well No. 1 Noland

C. H. Hyde et al. Company

**FIRST REPORT** Contractor

C W L NW NW

660 Ft. from N. Line

\_\_\_\_\_ Ft. from S. Line

\_\_\_\_\_ Ft. from E. Line

330 Ft. from W. Line

SECTION PLAT

0			

Rice County

Location \_\_\_\_\_

Rig up \_\_\_\_\_

Drilling and Remarks:

surface hole

RECORD

Cased \_\_\_\_\_ in., \_\_\_\_\_ ft.

Sand \_\_\_\_\_

Gas \_\_\_\_\_

Oil \_\_\_\_\_

Total Depth \_\_\_\_\_

PRODUCTION

1st 24 hrs. Nat. \_\_\_\_\_

1st 24 hrs. after shot \_\_\_\_\_

Gas \_\_\_\_\_ Cu. Ft.

Dry Hole \_\_\_\_\_

Abandoned \_\_\_\_\_

Date

JAN 2 1947 19

S. J. LEWIS Scout

KANSAS

Map No. 46 Sec. 14 Twp. 20 R. 10W

Well No. 1 Noland

C. H. Hyde et al. Company

ABANDONED

Contractor

C W L NW NW

*E. 1, 1908*  
SECTION PLAT

660 Ft. from N. Line

\_\_\_\_\_ Ft. from S. Line

\_\_\_\_\_ Ft. from E. Line

330 Ft. from W. Line

6			

Rice County

Location \_\_\_\_\_

Rig up \_\_\_\_\_

Drilling and Remarks:

*Liams 8066  
5" @ 140*

RECORD

Cased \_\_\_\_\_ in., \_\_\_\_\_ ft.

Sand \_\_\_\_\_

Gas \_\_\_\_\_

Oil \_\_\_\_\_

Total Depth 3277

PRODUCTION

1st 24 hrs. Nat. \_\_\_\_\_

1st 24 hrs. after shot \_\_\_\_\_

Gas \_\_\_\_\_ Cu. Ft.

Dry Hole \_\_\_\_\_

Abandoned \_\_\_\_\_

Date

FEB 12 1947 19

S. J. LEWIS Scout