


SECTION 30 TOWNSHIP 31 RANGE 5E

WELL NO. #3 Bender "A"

COMPANY O.A. Sutton

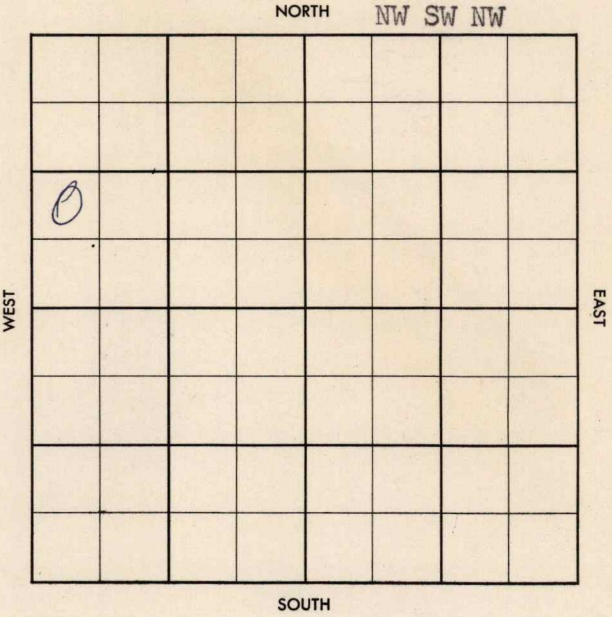

County Cowley Elev. _____
 Sec. 30 Twp. 31 Rge. 5E
 Company O. A. Sutton
 FarmName Bender "A" No. 1

TOPS	DEPTH	LOG	DATUM	Loc. in Sec.
Anh.				NW SW NW
Tp.				
H.				
Tr.				
Dg.				
Bl.				
L.				Geol. _____
K.C.				Contr. _____
B.K.C.				
Ce.				<u>Renfro Tools</u>
C.				Pool _____
M.				
M.				
K.				
Mz.				<u>Wilmot-Floral</u>
Mo.				
V.				
S.				
S.				
A				
R.				
Pe.				
G.				
T.D.				

JUN 5 '57
 o
 FIRST REPORT

Date Comm. 6-4-57
 Delg. 40

~~29~~

Co.
Lse.
No.
Sec.
T.
R.

CORRECTION

FORM 513 SUNRAY

County Cowley Elev. 1221
 Sec. 30 Twp. 31 Rge. 5E
 Company O. A. Sutton
 Farm Name Bender ~~4511~~ No. 13

TOPS	DEPTH	LOG	DATUM	Loc. in Sec.
Anh.				NW SW NW
T.P.				
H. <u>stain</u>	<u>1847</u>			
Tr. <u>Lay</u>	<u>2265</u>			
Dg.				
Bl.				
L.				Geol.
K.C.	<u>2356</u>			Contr.
B.K.C. <u>osw</u>	<u>2606</u>			
Ce.				
C.				Renfro Tools
M. <u>Bartl.</u>	<u>2871</u>			Pool
M.	<u>2937</u>			Wilmot-Floral
K.				
Mz.				
Ma.				
V.				
S.				
S.				
A.				
R.				
PE.				
G.				
TD.	<u>2947</u>			

JUL 17 57

COMPLETE

Date Comm. 6-4-57

Drlg. 40 JUN 12 '57 85/8 203/150

1) 2915 JUN 19 '57 crd 2270-85

Full rec DST 2938-47 1hr

rec 815' GIP rec 27' oil &

CCM FP 0-30 BHP 225/20"

5 1/2 @ 2939/50 rev. JUN 25 '57

CO DD 2952 TD STOCK Bfg

JUL 3 '57 DD 2952 N.S. PB 2920

79/2876-86 9/2872-73

B 10 Goph 1/2" \$ 32 Goph
 8 hrs FRAC Flwd 239

B0 Flwd 38 B0 in 1hr

3/4" ch JUL 10 57 JUL 17 57 Flw 62

B0 3 hrs 1/2" ch Flw

25 Bopd