

KANSAS


Section 15 Township 20 Range 10W

Well No. #1 Koenig

Company Hyde & Stormfeltz

SILICA POOL

NORTH

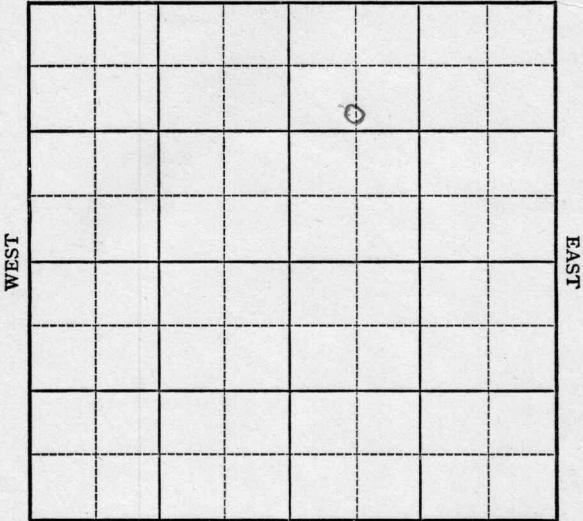

SOUTH

Sec. 15 Twp. 20 R. 10-W

Well No. #1 Koenig Farm

Hyde & Stormfeltz Company

(Silica Pool)


990 Ft. from N. Line

\_\_\_\_\_ Ft. from S. Line

\_\_\_\_\_ Ft. from E. Line

660 Ft. from W. Line

*Elev. 1820'*

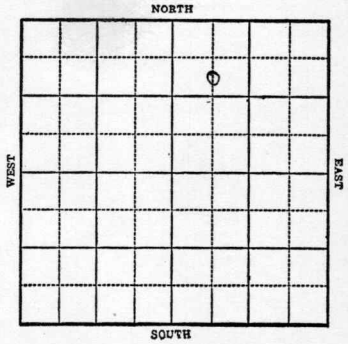

1942

R E P O R T

10/14

Rotary

10/21

10" @ 150' Drlg 2200'

10/28

Lans 3085  
7" @ 3115 TD SD Rust

11/4

" " " "

11/11

TD 3182' SO  
6000 Acid

11/18

Lans. 3085  
7" @ 3115'  
T.D. 3182'  
Pump 150 bbls. Pot.  
6000 Acid  
Gravity 45

Rice

KANSAS

Map No. 46 Sec. 15 Twp. 20 R. 10W

Well No. 1 Koenig

Hyde & Stormfeltz Company

FIRST REPORT Contractor

C SL NW NE

SECTION PLAT

990 Ft. from N. Line

\_\_\_\_\_ Ft. from S. Line

\_\_\_\_\_ Ft. from E. Line

660 Ft. from W. Line

		o	

SILICA POOL

Location \_\_\_\_\_

Rig up \_\_\_\_\_

Drilling and Remarks:

Rotary

RECORD

Cased \_\_\_\_\_ in., \_\_\_\_\_ ft.

Sand \_\_\_\_\_

Gas \_\_\_\_\_

Oil \_\_\_\_\_

Total Depth \_\_\_\_\_

PRODUCTION

1st 24 hrs. Nat. \_\_\_\_\_

1st 24 hrs. after shot \_\_\_\_\_

Gas \_\_\_\_\_ Cu. Ft.

Dry Hole \_\_\_\_\_

Abandoned \_\_\_\_\_

Date

OCT 14 1942 19 \_\_\_\_\_

S. J. LEWIS Scout

KANSAS

Rice

Map No. 46 Sec. 15 Twp. 20 R. 10W

Well No. 1 Koenig

Hyde & Stormfeltz Company

COMPLETED Contractor

C SL NW NE

SECTION PLAT

990 Ft. from N. Line

\_\_\_\_\_ Ft. from S. Line

\_\_\_\_\_ Ft. from E. Line

660 Ft. from W. Line

		o	

SILICA POOL

Location \_\_\_\_\_

Rig up \_\_\_\_\_

Drilling and Remarks:

*Loss 3085.*  
*7" @ 3115.*  
*6000 Cecil*  
*Pump 150 Pst*  
*45° G*

RECORD

Cased \_\_\_\_\_ in., \_\_\_\_\_ ft.

Sand \_\_\_\_\_

Gas \_\_\_\_\_

Oil \_\_\_\_\_

Total Depth 3182

PRODUCTION

1st 24 hrs. Nat. \_\_\_\_\_

1st 24 hrs. after shot \_\_\_\_\_

Gas \_\_\_\_\_ Cu. Ft.

Dry Hole \_\_\_\_\_

Abandoned \_\_\_\_\_

Date

NOV 18 1942

19

S. J. LEWIS

Scout