


Barton

Section 9 Township 20 Range 13-W

Well No. #1 Hart

Company R. W. Rine Drlg.

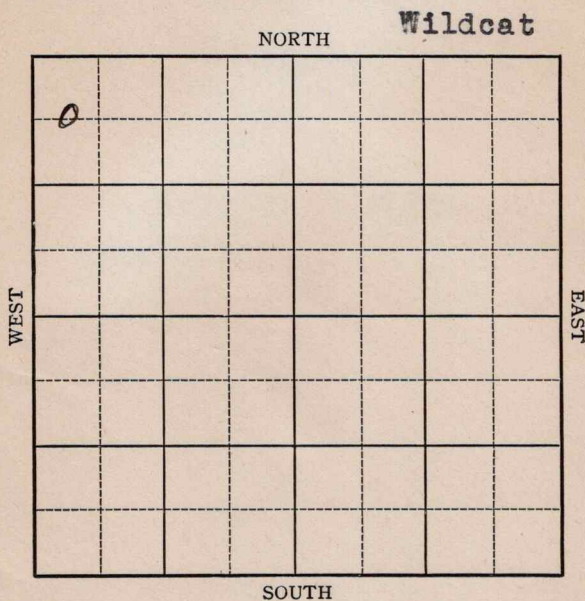

KANSAS


Barton

Sec. 9 Twp. 20 R. 13 -WWell No. #1 Hart FarmR. W. Rine Drlg. Company

(Wildcat)

660 Ft. from N. Line Ft. from S. Line Ft. from E. Line330 Ft. from W. Line

Elev. 1868

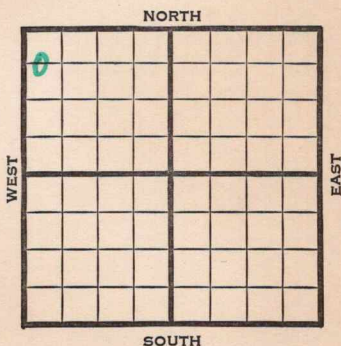

1941

REPORT

4/23

Rotary.

5/1

Surface hole.

5/8

8" - 351' Topeka 2835'

Drlg. 3125'

5/14

Arb. 3494'

T.D. 3544'

No shows.

ABANDONED

Map No. 82 Sec. 9 Twp. 20 R. 13WWell No. 1 Hart

R. W. Rine Drlg.

Company

FIRST REPORT

Contractor

SECTION PLAT

C W L NW NW

660 Ft. from N. Line Ft. from S. Line Ft. from E. Line330 Ft. from W. Line

WILDCAT

0			

Location Rig up

Drilling and Remarks:

Rotary

RECORD

Cased in., ft.Sand Gas Oil Total Depth

PRODUCTION

1st 24 hrs. Nat. 1st 24 hrs. after shot Gas Cu. Ft.Dry Hole Abandoned

Date

APR 23 1941 19

S. J. LEWIS

Scout

Map No. 82 Sec. 9 Twp. 20 R. 13WWell No. 1 HartR. W. Rine Drilling CompanyABANDONED Contractor

C W L NW NW

660 Ft. from N. Line Ft. from S. Line Ft. from E. Line330 Ft. from W. Line

WILDCAT

SECTION PLAT

0			

Location Rig up

Drilling and Remarks:

*Cor 83494**No shows*

RECORD

Cased in., ft.Sand Gas Oil Total Depth 3544

PRODUCTION

1st 24 hrs. Nat. 1st 24 hrs. after shot Gas Cu. Ft.Dry Hole Abandoned

Date

MAY 14 1941 19

S. J. LEWIS

Scout