

KANSAS


FORM 51 5M 6-46 PETROL

Cowley

Section 23 Township 31 Range 4E

Well No. 2 Diechman

Company Ben Gralapp Etal.

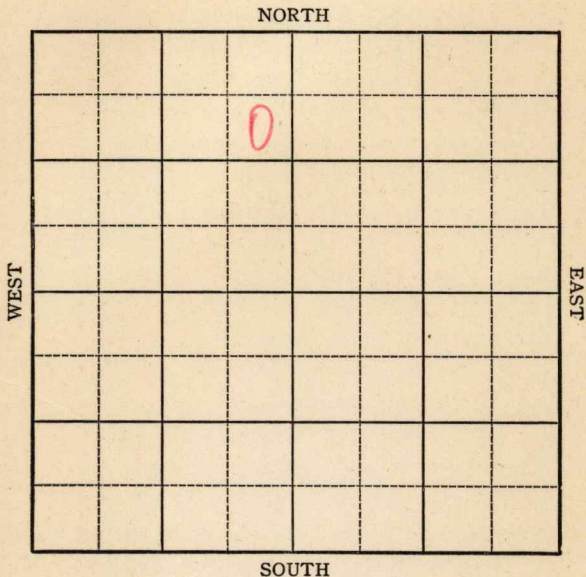

KANSAS

Cowley County ✓

Sec. 23 Twp. 31 R. 4E

Well No. #2 Diechman Farm

Ben Gralapp et al Company

Miscellaneous


990 Ft. from N. Line

_____ Ft. from S. Line

330 Ft. from E. Line

_____ Ft. from W. Line

SE NE NW

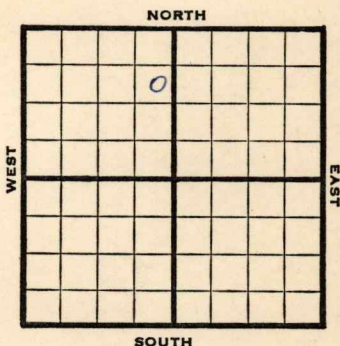

1946 1274 Elev. REPORT

7/3 RUR

7/9 10" @ 65
Drlg 1915'

7/16 **Bart 2946-**
2960 TD
5" @ 2946 RUST

7/23 " "

7/30 TD 2996
Pump 80 oil 24 hrs

8/7 **Bart 2946**
5" @ 2946
TD 2996'
Pump 132 Pot.
Grav. 40.0

COMPLETED

Kansas Pool Name Miscellaneous

Map No. 2 Sec. 23 Twp. 31 R. 4E

Well No. 2 Diechman

Ben Gralapp Etal. Company

FIRST REPORT Contractor

SE NE NW

SECTION PLAT

990 Ft. from N. Line

		o	

_____ Ft. from S. Line

330 Ft. from E. Line

_____ Ft. from W. Line

Cowley County

Location _____

Rig up _____

Drilling and Remarks:

R U R

RECORD

~~Cased~~ _____ in., _____ ft.

Sand _____

Gas _____

Oil _____

Total Depth _____

PRODUCTION

1st 24 hrs. Nat. _____

1st 24 hrs. after shot _____

Gas _____ Cu. Ft.

Dry Hole _____

Abandoned _____

Date

JUL 3 1946 19 _____

S. J. LEWIS Scout

KANSAS

Kansas

Pool Name Miscellaneous

Map No. 2 Sec. 23 Twp. 31 R. 4E

Well No. 2 Diechman

Ben Gralapp etal Company

COMPLETED

Contractor

SE NE NW

E1, 1274

SECTION PLAT

990 Ft. from N. Line

_____ Ft. from S. Line

330 Ft. from E. Line

_____ Ft. from W. Line

	o		

Cowley County

Location _____

Rig up _____

Drilling and Remarks:

Bar 2946

5" @ 2946

Pump 132 Pot

40° Gr

RECORD

Cased _____ in., _____ ft.

Sand _____

Gas _____

Oil _____

Total Depth 2996

PRODUCTION

1st 24 hrs. Nat. _____

1st 24 hrs. after shot _____

Gas _____ Cu. Ft.

Dry Hole _____

Abandoned _____

Date

AUG 7 1946

19

S. J. LEWIS

Scout