
DX 78-1 Barton

KANSAS

Section 9 Township 20 Range 13W

Well No. #1 Schartz

Company Alkay Oil

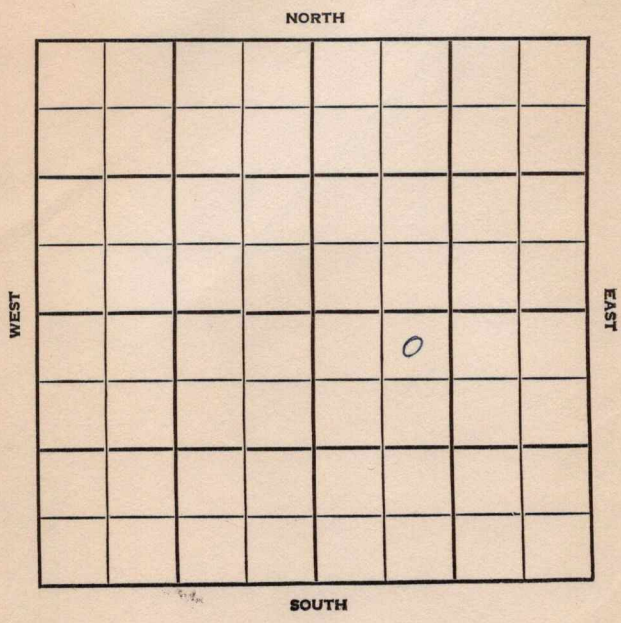

Barton KANSAS

SEC.	TWP.	R.
9	20 S	13 W

WELL NO.

1 Schartz FARM

COMPANY

Alkay Oil

CONTRACTOR

Badger
S. Bend


_____ Ft. from N. Line

_____ Ft. from S. Line

_____ Ft. from E. Line

_____ Ft. from W. Line

NE NW SE

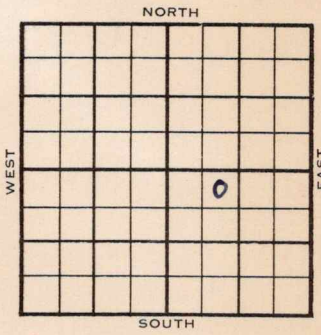

(990' North Company Acreage)

1955	ELEVATION 1860' DF REPORT
6/9	RUR
6/16	Spud 6-6-55 8-5/8" @ 254 w/175 Anhy 720' Heeb 3090' Br. lime 3202', Lans 3214' Drlg. 3438'
6/22	Comm 6-6-55 Anh 720 H 3090 Bl 3202 L 3214 C Chert 3457 A 3502 TD 3525 8 5/8" @ 254/175 D & A

ABANDONED

DX-78

FORM 513 REV. SUNRAY

County Barton Elev.

Sec. 9 Twp. 20 Rge. 13W

Company Alkay Oil

Farm Name Scharts No. 1

TOPS	DEPTH	LOG	DATUM
Anh.			
Tp.			
H.			
Tr.			
Dg.			
Bl.			
L.			
K.C.			
B.K.C.			
Ce.			
C.			
M.			
M.			
K.			
Mz.			
Mq.			
V.			
S.			
S.			
A			
R.			
P€.			
G.			
T.D.			


Loc. in Sec. NE NW SE

990' N. Co. Hwy

Geol.

Contr. Badger

Pool S. Bend

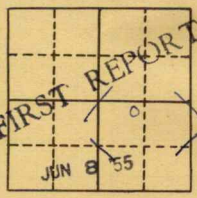

Date Comm. R U R

Co. Lse. No. Sec. T. R.

FORM 513 REV. SUNRAY

County Barton Elev. 1860

Sec. 9 Twp. 20 Rge. 13W

Company Alkay Oil

Farm Name Schartz No. 1

TOPS	DEPTH	LOG	DATUM
Anh.	720		
Tp.			
H.	3090		1230
Tr.			
Dg.			
Bl.	3202		1342
L.	3214		1354
K.C.			
B.K.C.			
Ce.			
C. chert	3457		1597
M.			
M.			
K.			
Mz.			
Mo.			
V.			
S.			
S.			
A	3502		1642
R.			
P€.			
G.			
T.D.	3525		1665

Loc. in Sec. NE NW SE

Geol.

Contr. Badger

Pool S. Bend



Date Comm. 6-6-55 JUN 2 2 1955

8 5/8" @ 254/175

D & A

Co. Lse. No. Sec. T. R.