

KANSAS

Rice

Section 15 Township 20 Range 10WWell No. 3 KoenigCompany Hyde & Stormfeltz

Raymond

NORTH

				0			

WEST

EAST

SOUTH

KANSAS

Rice

Sec. 15 Twp. 20 R. 10W ✓

Well No. #3 Koenig Farm

Hyde & Stormfeltz

Raymond Pool (Mallard Drlg., Cont.) Company


 Ft. from N. Line

330' Ft. from S. Line

 Ft. from E. Line

330' Ft. from W. Line

SW NE

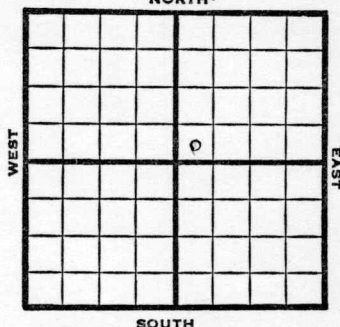

1949

Elev 1829'

REPORT

5/25 Surface Hole
6/1 10"@ 155'
Indian Cave 2358'
TD 2358'
7"@ 2357'
6/8 Indian Cave 2855 (Corrected)
7"@ 2355'
TD 2364 wtr.
Aband.
ABANDONED

Map No. _____ Sec. 15 Twp. 20 R. 10W

Well No. 3 Koenig

Hyde & Stormfeltz Company

Mallard Drlg. Contractor

SW NE

FIRST REPORT
SECTION PLAT

_____ Ft. from N. Line

330 Ft. from S. Line

_____ Ft. from E. Line

330 Ft. from W. Line

Rice County

Location _____

Rig up _____

Drilling and Remarks:

surface hole

RECORD

Cased _____ in., _____ ft.

Sand _____

Gas _____

Oil _____

Total Depth _____

PRODUCTION

1st 24 hrs. Nat. _____

1st 24 hrs. after shot _____

Gas _____ Cu. Ft.

Dry Hole _____

Abandoned _____

Date

MAY 25 1949 19

S. J. LEWIS

Scout

Rice County Kansas State

Map No. K44 Sec. 15 Twp. 20 R. 10W

Well No. 3 Koenig

Hyde & Stormfeltz Company

ABANDONED Contractor

SW NE

E 11829

SECTION PLAT

 Ft. from N. Line

330 Ft. from S. Line

 Ft. from E. Line

330 Ft. from W. Line

Raymond Pool

Remarks:

Inokan Cave. 2855 connected

7" @ 2855

7152364 Water

Date JUN 8 1949

Scout S. J. LEWIS