


Section 23 Township 31 Range 4E

Well No. 8 Deitchman

Company Kanotex Ref.

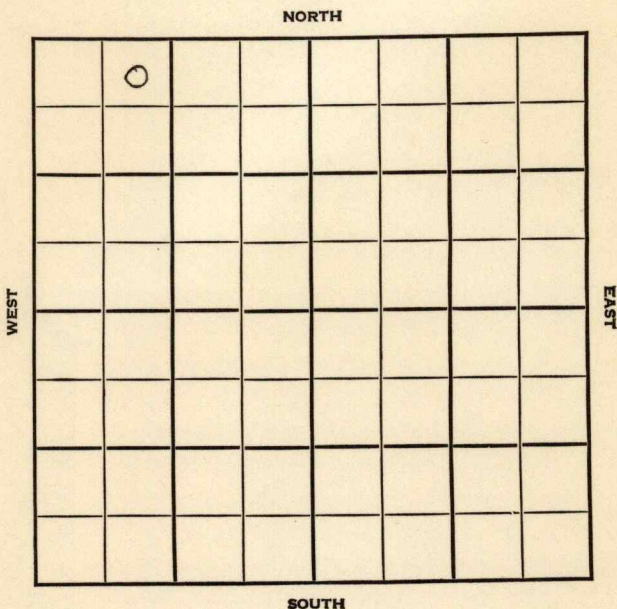

Sec. 23 Twp. 31 R. 4E

Well No. #8 Deitchman Farm

Kanotex Ref. Company

Misc.


330 Ft. from N. Line

_____ Ft. from S. Line

_____ Ft. from E. Line

990 Ft. from W. Line

NE NW NW

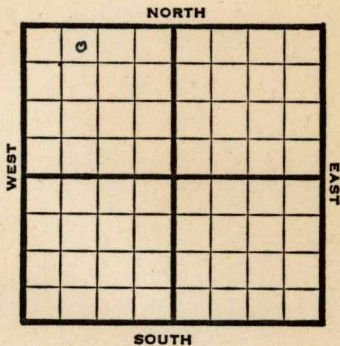

1947 **Elev. 1295'** REPORT

12/17 10" @ 113'
Drlg. 120'

1948

1/7 **Bart. 2976'**
5" @ 2976'
120 qts
Pump 35 oil & 10 W Pot.
Gr. 38°
Total Depth 3031'

COMPLETED

Map No. _____ Sec. 23 Twp. 31 R. 4 E

Well No. 8 Deitchman

Kanotex Ref. Company

FIRST REPORT

Contractor

NE NW NW

SECTION PLAT

330 Ft. from N. Line

_____ Ft. from S. Line

_____ Ft. from E. Line

990 Ft. from W. Line

o			

Cowley County

Location _____

Rig up _____

Drilling and Remarks:

10" @ 113

drlg. 120

RECORD

Cased _____ in., _____ ft.

Sand _____

Gas _____

Oil _____

Total Depth _____

PRODUCTION

1st 24 hrs. Nat. _____

1st 24 hrs. after shot _____

Gas _____ Cu. Ft.

Dry Hole _____

Abandoned _____

Date

DEC 17 1947 19

S. J. LEWIS Scout

Kansas

Map No. 2 Sec. 23 Twp. 31 R. 4E

Well No. 8 Deitchman

Kanotex Ref. Company

COMPLETE Contractor

NE NW NW

E 1, 1295
SECTION PLAT

330 Ft. from N. Line

 Ft. from S. Line

 Ft. from E. Line

990 Ft. from W. Line

4			

Cowley County

Location

Rig up

Drilling and Remarks:

Bar 2976
5' @ 2976
1209 to
Pump 85 oil + 10W
Pa 8
38° S

RECORD

Cased in., ft.

Sand

Gas

Oil

Total Depth 3031

PRODUCTION

1st 24 hrs. Nat.

1st 24 hrs. after shot

Gas Cu. Ft.

Dry Hole

Abandoned

Date

JAN 7 1948 19

S. J. LEWIS Scout