

Well No. 1-Specht Farm

Well No. 1- Specht Farm
Tom Palmer Company

WEST

EAST

SOUTH

Rig Up_____

Drilling Remarks

PRODUCTION

Cased _____ in. _____ ft.

1st 24 hrs. Nat.-----

Sand.....

1st 24 hrs. after shot-----

Gas

Gas _____ cu. ft. _____

Oil_____

Dry Hole.....

Total Depth-----

Abandoned_____

KANSAS

Map No. _____ Sec. 16 Twp. 20 R. 10 W

Well No. 1 Specht Farm _____


Tom Palmer Company _____

_____ Ft. from N. Line

330' Ft. from S. Line

_____ Ft. from E. Line

850' Ft. from W. Line

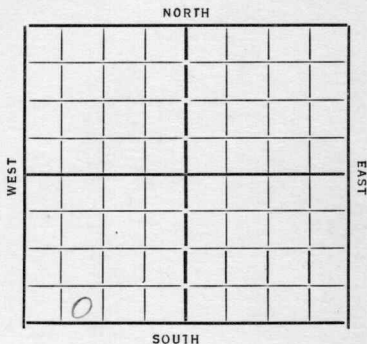

Date 1/23

REPORT

7/5 Material

7/12 Rig

7/19 20" - 70'

7/26 dily 1025

8/2 12" 1334 dily 1735'

8/9 10" 2072 " 2125'

8/17 Work 2440'

8/23 8" 2664 dily 2455'

8/30 6" 3056 Pay 3130-40' P.B. to 3138 1/2
750' oil 3 hrs

9/6 Treated with 1000 gal acid
pump 410 oil - 17 1/2 water

9/13
9/20 set engine 9/29

10/4 Silicious 3130

T.D. 3140 1000 gallon
acid pump 415 oil
21 water

COMPLETED

KANSASMap No. 46 Sec. 16 Twp. 20 R. 10WWell No. 1-SpechtTom Palmer CompanySW Contractor

SECTION PLAT

Ft. from N. Line

330 Ft. from S. Line

Ft. from E. Line

850 Ft. from W. Line

FIRST REPORTS

Location

Rig up

Drilling and Remarks:

material

RECORD

Cased in., ft.

Sand

Gas

Oil

Total Depth

PRODUCTION

1st 24 hrs. Nat.

1st 24 hrs. after shot

Gas Cu. Ft.

Dry Hole

Abandoned

Date

7/5/33 192 O. Mannerbeck Scout

Map No. 46 Sec. 16 Twp. 20 R. 10W

Well No. 1- Specht

Tom Palmer Company

Contractor

SECTION PLAT

0			

Ft. from N. Line

330 Ft. from S. Line

Ft. from E. Line

850 Ft. from W. Line

COMPLETED

Location

Rig up

Drilling and Remarks:

1000 gal and
pump 415 oil
21 W

RECORD

Cased _____ in., _____ ft.

Sand delusion 3130

Gas _____

Oil _____

Total Depth 3140

PRODUCTION

1st 24 hrs. Nat. _____

1st 24 hrs. after shot _____

Gas _____ Cu. Ft.

Dry Hole _____

Abandoned _____

Date

OCT 4 1933
192

O. Mannschied Scout