


Cowley

Section 23 Township 31 Range 4-E

Well No. #2 Franks

Company Trees Oil

Hittle Pool

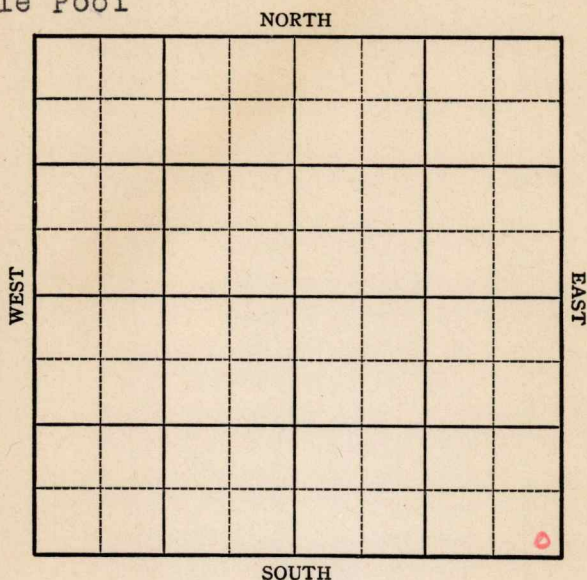

Sec. 23 Twp. 31 R. 4-E

Well No. #2 Franks Farm

Trees Oil Company

(Hittle Pool)


 Ft. from N. Line

330 Ft. from S. Line

330 Ft. from E. Line

 Ft. from W. Line

Elev. 1204

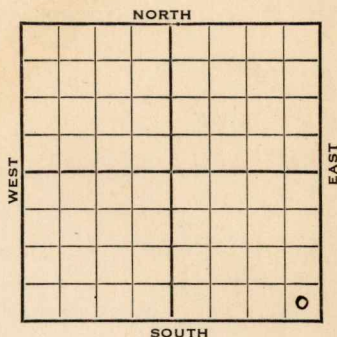

1942

REPORT

9/16 Location

9/23 Cable Rig

9/30 "

10/7 15" - 325 Drlg. 1120'

10/14 Barb. 2943 7" @ 2930

TD 2970 PB 2960

15 qts 2945-60 CO

10/21 Drlg 1800'

10/28 2205 Drlg.

11/4 Drlg. 2700

11/11 Drlg. 2870'

11/18 Miss. 2940

T.D. 2943

No shows.

ABANDONED

KANSAS

Cowley

Map No. 2 Sec. 23 Twp. 31 R. 4EWell No. 2 Franks

Trees Oil


Company

FIRST REPORT

Contractor

SE/C

SECTION PLAT

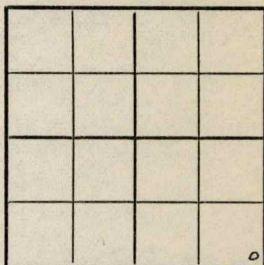

Ft. from N. Line

330

Ft. from S. Line

330

Ft. from E. Line

Ft. from W. Line

HITTLE POOL

Location XXX

Rig up

Drilling and Remarks:

RECORD

Cased _____ in., _____ ft.

Sand _____

Gas _____

Oil _____

Total Depth _____

PRODUCTION

1st 24 hrs. Nat. _____

1st 24 hrs. after shot _____

Gas _____

Cu. Ft.

Dry Hole _____

Abandoned _____

Date

SEP 16 1942

19

S. J. LEWIS


Scout

KANSAS

Map No. 2 Sec. 23 Twp. 31 R. 4EWell No. 2 FranksTrees Oil CompanyABANDONED Contractor

SE/C

SECTION PLAT

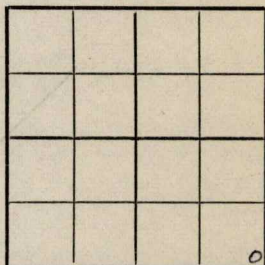 Ft. from N. Line330 Ft. from S. Line330 Ft. from E. Line Ft. from W. Line

HITTLE POOL

Location Rig up

Drilling and Remarks:

*Miss 2940**No shows*

RECORD

Cased in., ft.Sand Gas Oil Total Depth 2943

PRODUCTION

1st 24 hrs. Nat. 1st 24 hrs. after shot Gas Cu. Ft.Dry Hole Abandoned

Date

NOV 18 1942

19

S. J. LEWIS

Scout