


Form 51-5M-3-35-Mid-West

Map No. **KANSAS** Sec. **23** Twp. **31** R. **4-E**

Well No. **#1 Orr** Farm  
**Meade Bros. et al** Company

NORTH

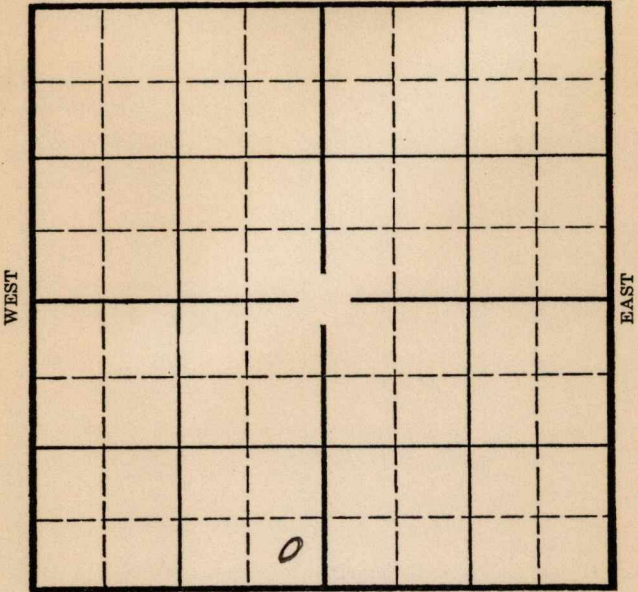

SOUTH

Location \_\_\_\_\_  
Drilling Remarks \_\_\_\_\_

Rig Up \_\_\_\_\_  
Drilling Remarks \_\_\_\_\_

\_\_\_\_\_  
\_\_\_\_\_  
**RECORD**

**PRODUCTION**

Cased \_\_\_\_\_ in. \_\_\_\_\_ ft.  
Sand \_\_\_\_\_  
Gas \_\_\_\_\_  
Oil \_\_\_\_\_  
Total Depth \_\_\_\_\_

1st 24 hrs. Nat. \_\_\_\_\_  
1st 24 hrs. after shot \_\_\_\_\_  
Gas \_\_\_\_\_ cu. ft. \_\_\_\_\_  
Dry Hole \_\_\_\_\_  
Abandoned \_\_\_\_\_

Cowley

Map No.            Sec. 23 Twp. 31 R. 4E

Well No. 1-Dr Farm             
Meade Bros. et al Company           


           Ft. from N. Line

330 Ft. from S. Line

330 Ft. from E. Line

           Ft. from W. Line

NORTH

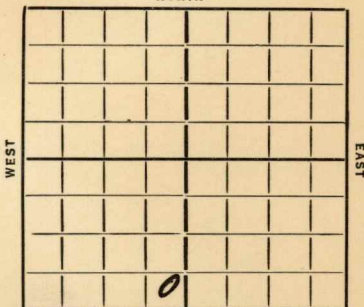

SOUTH

Elev. 1239

REPORT

<u>1936</u>	
<u>2/12</u>	<u>Cells &amp; Material</u>
<u>2/21</u>	<u>          </u>
<u>2/28</u>	<u>Rgn</u>
<u>3/13</u>	<u>15"-377 Drlg 675.</u>
<u>3/20</u>	<u>12"- 1069 Drlg. 1435</u>
<u>3/27</u>	<u>T.D. 1745' U.R. 10"</u>
<u>4/2</u>	<u>H.F.W. 1905-15' T.D. 2150' S.d.</u>
<u>4/10</u>	<u>Drlg. 2485'</u>
<u>4/16</u>	<u>Drlg. 2980'</u>
<u>4/22/36</u>	<u>Bart. 2951-71 S.O.</u>
	<u>Miss L. 2988'</u>
	<u>T.D. 3044'</u>
	<u>D &amp; A</u>
	<u>ABANDONED</u>

KANSAS

Map No. 2 Sec. 23 Twp. 31 R. 4E

Well No. 1-Or

Meade Bros et al Company

Contractor

FIRST REPORTS

SECTION PLAT


Ft. from N. Line

330 Ft. from S. Line

330 Ft. from E. Line

Ft. from W. Line

Location

Rig up

Drilling and Remarks:

*Clear + Material*

RECORD

Cased.....in., .....ft.

Sand.....

Gas.....

Oil.....

Total Depth.....

PRODUCTION

1st 24 hrs. Nat.....

1st 24 hrs. after shot.....

Gas.....Cu. Ft.

Dry Hole.....

Abandoned.....

Date

ORVAL MANNSCHRECK

2-12-36 192.....

Scout

*Cowley*  
 Map No. 2 Sec. 23 Twp. 31 R. 4E  
 Well No. 1 Orr

*Meads Bros et al* Company  
 Contractor

SECTION PLAT


..... Ft. from N. Line  
330 Ft. from S. Line  
330 Ft. from E. Line  
 ..... Ft. from W. Line

ABANDONED

Location.....

Rig up.....

Drilling and Remarks:

*Bar 2951-7180*

*Miss L 2988*

*J & A*

RECORD

Cased.....in., .....ft.

Sand.....

Gas.....

Oil.....

Total Depth 3044

PRODUCTION

1st 24 hrs. Nat.....

1st 24 hrs. after shot.....

Gas.....Cu. Ft.

Dry Hole.....

Abandoned.....

Date

APR 22 1936

192.....

S. J. LEWIS

Scout