

KANSAS



Sec. 23 Twp. 31 R. 4-E

Well No. # 6 Deichman Farm

Kanotex Ref. Company


Miscellaneous

330 Ft. from N. Line

_____ Ft. from S. Line

_____ Ft. from E. Line

330 Ft. from W. Line

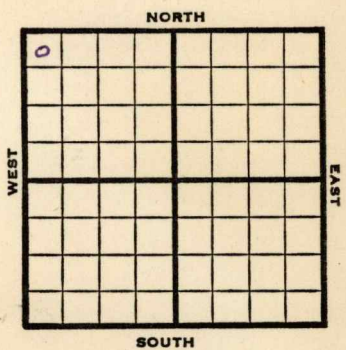

NW/C

1947 **EL. 1277'** REPORT

- 6/18 Location
- 6/24 8" @ 121'
Drlg. 2510'
- 7/1 **Bart 2960'**
TD 2965'
5 @ 2960'
- 7/8 TD 2988'
80 qts. 2960-88'
CO
- 7/16 "
- 7/22 "
- 7/29 "
- 8/6 "
- 8/13 **Bart 2960'**
5" @ 2960'
80 qts.
Pump 6l oil / 20 W
Pot.
Gr. 40
T.D. 2988'
Complete

COMPLETED

Map No. _____ Sec. 23 Twp. 31 R. 4E

Well No. 6 Deichman

Knotex Ref. Company _____

FIRST REPORT Contractor _____

NW/C

SECTION PLAT

330 Ft. from N. Line

_____ Ft. from S. Line

_____ Ft. from E. Line

330 Ft. from W. Line

0			

Cowley County

Location X

Rig up _____

Drilling and Remarks:

RECORD

Cased _____ in., _____ ft.

Sand _____

Gas _____

Oil _____

Total Depth _____

PRODUCTION

1st 24 hrs. Nat. _____

1st 24 hrs. after shot _____

Gas _____ Cu. Ft.

Dry Hole _____

Abandoned _____

Date

JUN 1 8 1947 19

S. J. LEWIS Scout

Map No. 2 Sec. 23 Twp. 31 R. 4E

Well No. 6 Deichman

Kanotex Ref. Company

COMPLETE

Contractor

NW/C

E 11277

SECTION PLAT

330 Ft. from N. Line

 Ft. from S. Line

 Ft. from E. Line

330 Ft. from W. Line

0			

Cowley County

Location

Rig up

Drilling and Remarks:

Bar Y 2960
5' 102860
80 g to
Pump 61 oil + 20W
BT
40 0/1W

RECORD

Cased in., ft.

Sand

Gas

Oil

Total Depth 2987

PRODUCTION

1st 24 hrs. Nat.

1st 24 hrs. after shot

Gas Cu. Ft.

Dry Hole

Abandoned

Date

AUG 13 1947 19

S. J. LEWIS Scout