

KANSAS

Cowley

Section 24 Township 31 Range 4E

Well No. 5 Deichman

Company Trees Oil

Misc.
NORTH

WEST

EAST

0

SOUTH

Cowley

KANSAS

Sec. 24 Twp. 31 R. 4E ✓

Well No. #5 Deichman Farm

Trees Oil

Miscellaneous (Wakefield, Cont.) Company

_____ Ft. from N. Line

990'


_____ Ft. from S. Line

990'

_____ Ft. from E. Line

_____ Ft. from W. Line

NW SE SW

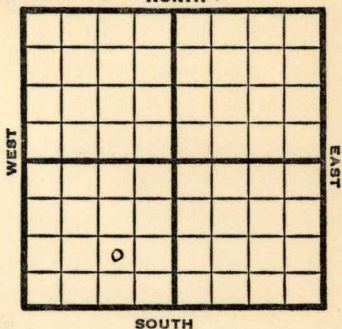

1949

Elev 1180'

REPORT

9/21

8" @ 100'

Dr1g. 185'

9/28

TD 2816'

5" @ 2816'

10/5

"

10/12

"

10/19

"

10/26

Bart 2831'

TD 2866'

96 qts CO

11/1

"

11/9

TD 2866'

Bart 2831'

5" @ 2816'

96 qts

Pump 50 Oil Pot

40° Gr.

Comp

COMPLETED

Map No. _____ Sec. 24 Twp. 31 R. 4E

Well No. 5 Deichman

Trees Oil Company

Wakefield Contractor

NW SE SW

**FIRST REPORT
SECTION PLAT**

_____ Ft. from N. Line

990 Ft. from S. Line

990 Ft. from E. Line

_____ Ft. from W. Line

Cowley County

Location _____

Rig up _____

Drilling and Remarks:

8" @ 100

drlg. 185

RECORD

Cased _____ in., _____ ft.

Sand _____

Gas _____

Oil _____

Total Depth _____

PRODUCTION

1st 24 hrs. Nat. _____

1st 24 hrs. after shot _____

Gas _____ Cu. Ft.

Dry Hole _____

Abandoned _____

Date

SEP 21 1949 19

S. J. LEWIS Scout

Map No. _____ Sec. 24 Twp. 31 R. 4E

Well No. 5 Deichman

Trees Oil Company

COMPLETE

Contractor

NW SE SW

E. 1/180
SECTION PLAT

	0		

_____ Ft. from N. Line

990 Ft. from S. Line

990 Ft. from E. Line

_____ Ft. from W. Line

Cowley County

Location _____

Rig up _____

Drilling and Remarks:

Base 42831

5" @ 2876

969 ft

Pump 58 oil

45° S

RECORD

Cased _____ in., _____ ft.

Sand _____

Gas _____

Oil _____

Total Depth 2866

PRODUCTION

1st 24 hrs. Nat. _____

1st 24 hrs. after shot _____

Gas _____ Cu. Ft.

Dry Hole _____

Abandoned _____

Date

NOV 9 1949 19

S. J. LEWIS Scout