


Section 16 Township 20 Range 10-W

Well No. #1 Graham

Company Stormfeltz & Hyde

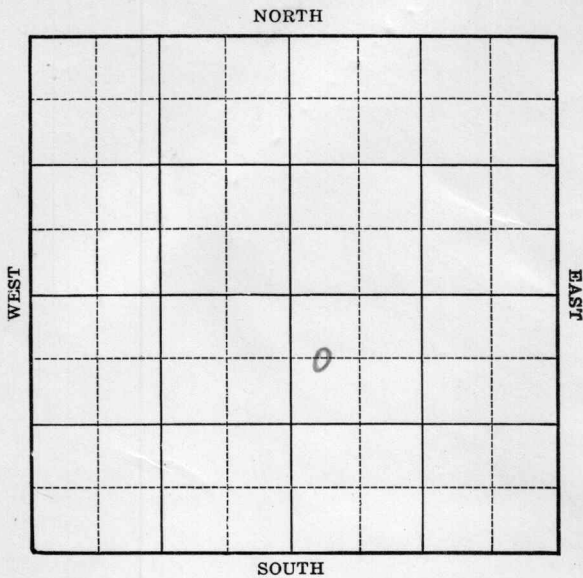


Sec. 16 Twp. 20 R. 10-WWell No. #1 Graham FarmStormfeltz & Hyde Company

(Raymond)

660 Ft. from N. Line Ft. from S. Line Ft. from E. Line330 Ft. from W. Line

Elev. 1820

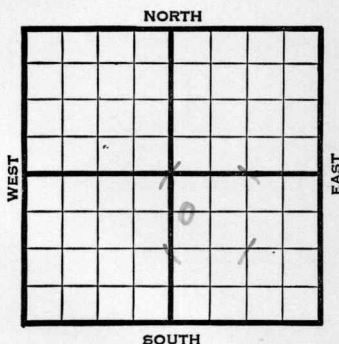

1941

REPORT

2/12 Rotary.

2/20 10" - 218' Drlg. 2310'

2/27 Anhy 460' Lans. 3079'

7" - 3130' RUST.

3/6 T.D. 3136' H.F.O.

3/12 Lans. 3079'

7" - 3130'

T.D. 3138'

1000 acid.

Potential 3239 bbls., Flow.

42.5 Gravity

COMPLETED

Rice

Map No. 46 Sec. 16 Twp. 20 R. 10WWell No. 1 Graham

Stormfeltz & Hyde


Company

FIRST REPORT

Contractor

C W L NW SE

SECTION PLAT

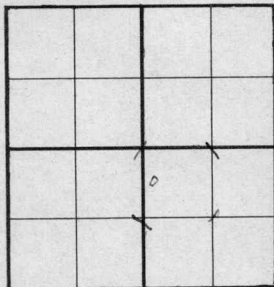660 Ft. from N. Line Ft. from S. Line Ft. from E. Line330 Ft. from W. Line

RAYMOND POOL

Location Rig up

Drilling and Remarks:

Rotary

RECORD

Cased in., ft.Sand Gas Oil Total Depth

PRODUCTION

1st 24 hrs. Nat. 1st 24 hrs. after shot Gas Cu. Ft.Dry Hole Abandoned

Date

FEB 12 1941

19

S. J. LEWIS Scout

Map No. 46 Sec. 16 Twp. 20 R. 10WWell No. 1 GrahamStormfeltz & Hyde Company

Contractor

COMPLETED

C W L NW SE

SECTION PLAT

660 Ft. from N. Line Ft. from S. Line Ft. from E. Line330 Ft. from W. Line

RAYMOND POOL

		o	

Location Rig up

Drilling and Remarks:

*Loss 3079**7" @ 3130**1000 acid**Flow 3239 Bt**42 5 Gr.*

RECORD

Cased in., ft.Sand Gas Oil Total Depth 3135

PRODUCTION

1st 24 hrs. Nat. 1st 24 hrs. after shot Gas Cu. Ft.Dry Hole Abandoned

Date

MAR 12 1941 19

S. J. LEWIS Scout