


Section 10 Township 20 Range 13-W

Well No. #1 Selle

Company National Assoc. Pet

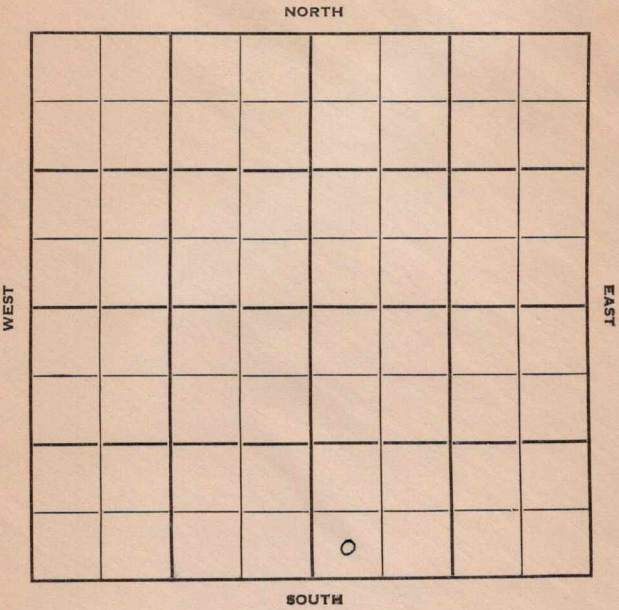

Barton

KANSAS

Sec. 10 Twp. 20 R. 13W

Well No. #1 Selle Farm ✓

National Assoc. Pet.

Company

Wildcat

Contractor

Ft. from N. Line

330'


Ft. from S. Line

Ft. from E. Line

330'

Ft. from W. Line

SW SW SE

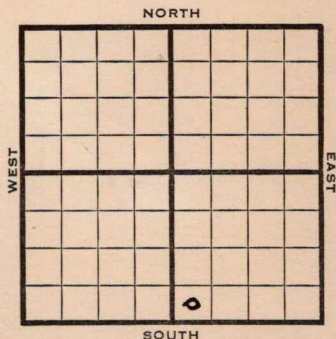

1950

Elev 1859

REPORT

8/16

Cellar & Pits

9/13

Spud 8-16-50

8 5/8" @ 355

Anhy 705

Top 2849

Heeb 3093

Toronto 3118

Br lime 3209

Lans 3224

DST 3246-53 op 1 hr rec 6' drlgmud

DST 3279-94 op 1 hr rec 6' mud

B KC 3456

Cong 3470

Arb 3532

DST 3472-80 op 1 hr rec 6' mud

DST 3480-91 op 1 hr rec 5' mud

DST 3489-3500 op 1 hr rec 22' drlg mud


DST 3503-10 op 1 hr rec 9' mud

DST 3515-41 op 1 hr rec 60' socm

TD 3567

D&A

ABANDONED

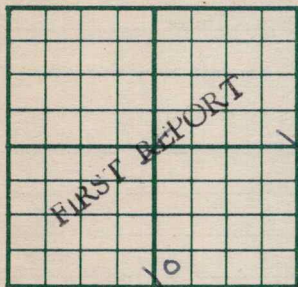County Barton State KansasSec. 10 (Blk.) 20 (Sur.) 13W Map No.Operator National Assoc. Pet.Well No. 1 Farm SelleElev. Location SW SW SE330 Ft. From S Line SE330 Ft. From W Line Quarter1st. Report AUG 16 1950

Completion


Remarks

Spudding Date

Drlg. Data WildcatCellar & pits

J. E. TYRA

County Barton State Kansas
 Sec. 10 (Blk.) 20 (Sur.) 13W Map No.
 Operator National Assoc. Pet.
 Well No. 1 Farm Selle
 Elev. 1859 Location SW SW SE

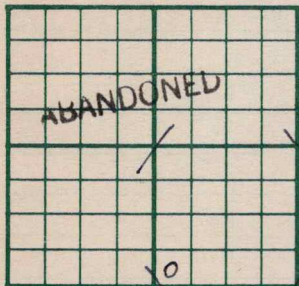

330 Ft. From S Line SE
330 Ft. From W Line Quarter
 1st. Report
 Completion SEP 13 1950
 Remarks
Wildcat
 Spudding Date 8-16-50

Drlg. Data D & A TD 3567
8 5/8" @ 355 Anhy 705 Top. 2849
Heeb. 3093 Toronto 3118 Br. lime 3209
Lans. 3224 DST 3246-53 open 1 hr.
Rec. 6' drlg. mud DST 3279-94 open 1 hr.
Rec. 6' mud B KC 3456 Cong. 3470
Arb. 3532 DST 3473-80 open 1 hr.
Rec. 6' mud DST 3480-91 open 1 hr.
Rec. 5' mud DST 3489-3500 open 1 hr.
Rec. 22' drlg. mud DST 3503-10 open 1 hr.
Rec. 9' mud DST 3515-41 open 1 hr.
Rec. 60' socm TD 3567

D & A

J. E. TYRA