

DX 78-1


Cowley

KANSAS

Section 23 Township 31 Range 1E

Well No. #1 Franks

Company McNeish & Gralapp

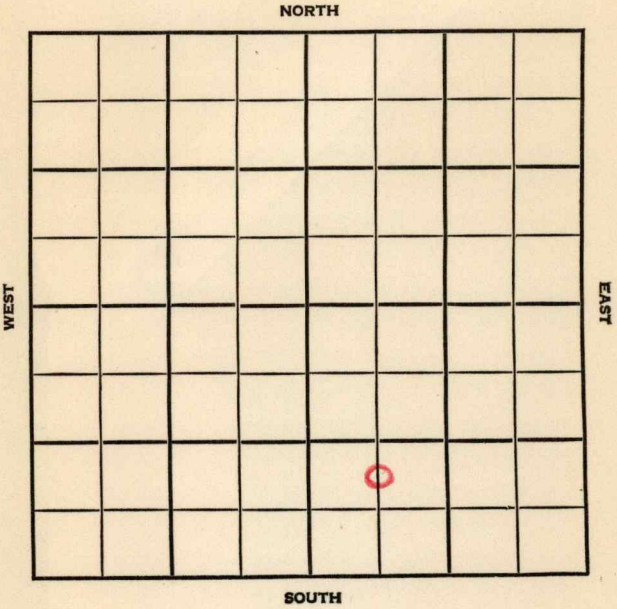

Cowley

KANSAS

SEC. 23	TWP. 31	R. 4E
------------	------------	----------

WELL NO.

1 Franks

FARM

COMPANY

McNeish & Grallapp

CONTRACTOR

Watson

Diechman Pool


_____ Ft. from N. Line

990' _____ Ft. from S. Line

_____ Ft. from E. Line

660' _____ Ft. from W. Line

C N 1/2 SW SE

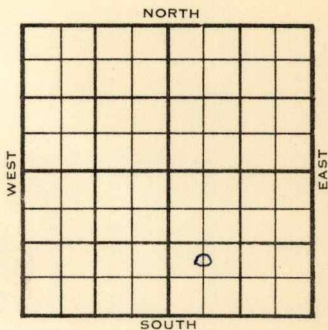

	ELEVATION	REPORT
1955	1226	

5/25 8" @ 88

6/8 KC 2287, Bart 2927
8" @ 88/80
? D & A

ABANDONED

County Cowley ✓ Elev. 1226
 Sec. 23 Twp. 31 Rge. 4E
 Company McNeish & Gralapp
 Farm Name Franks No. 1

TOPS	DEPTH	LOG	DATUM
Anh.			
Tp.			
H.			
Tr.			
Dg.			
Bl.			
L.			
K.C.	2287		1061
B.K.C. <i>Bart</i>	2927		1701
Ce.			
C.			
M.			
M.			
K.			
Mz.			
Mo.			
V.			
S.			
S.			
A.			
R.			
Pe.			
G.			
T.D.			

Loc. in Sec. _____
C N $\frac{1}{2}$ SW SE
1200' SL
790' WL
 Geol. _____
 Contr. _____
Watson
 Pool _____
Diechman

ABANDONED
 JUN 8 55
 0

Date Comm. 8 " @ 88/80
D & A

Co. Lse. No. Sec. T. R.