

# KANSAS

Rice


Form 51-5M-7-40-Palace

Section 16 Township 20 Range 10-W

Well No. #1 Specht

Company Stoenfeldt & Hyde

NORTH Silica Pool

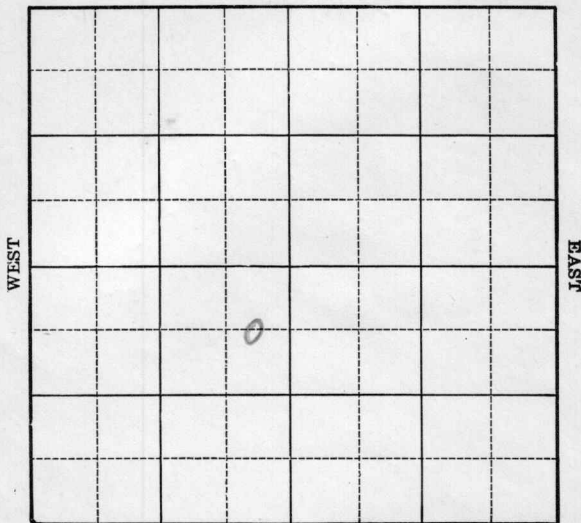

SOUTH



1940

12/11

Lans. 3084'

6" - 3094'

T.D. 3160'

2000 acid.

Depthograph potential 3270 bbls.

Maximum 3000 bbls.

45. Gravity

COMPLETED

Map No. 46 Sec. 16 Twp. 20 R. 10W

Well No. 1 Specht

Stoenfeldt & Hyde Company

Contractor

**FIRST REPORT**

C E L N E SW

660 Ft. from N. Line


\_\_\_\_\_ Ft. from S. Line

330 Ft. from E. Line

\_\_\_\_\_ Ft. from W. Line

SILICA POOL

**SECTION PLAT**

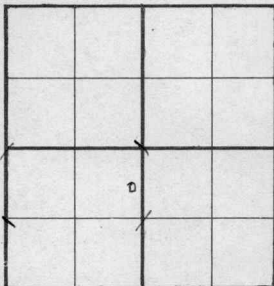

Location \_\_\_\_\_

Rig up \_\_\_\_\_

Drilling and Remarks:

Cable

**RECORD**

Cased \_\_\_\_\_ in., \_\_\_\_\_ ft.

Sand \_\_\_\_\_

Gas \_\_\_\_\_

Oil \_\_\_\_\_

Total Depth \_\_\_\_\_

**PRODUCTION**

1st 24 hrs. Nat. \_\_\_\_\_

1st 24 hrs. after shot \_\_\_\_\_

Gas \_\_\_\_\_ Cu. Ft.

Dry Hole \_\_\_\_\_

Abandoned \_\_\_\_\_

Date

OCT 9 1940

S. J. LEWIS Scout

Map No. 46 Sec. 16 Twp. 20 R. 10WWell No. 1 SpechtStornfeldt-Hyde Company

Contractor

COMPLETED

## SECTION PLAT

C E L N E S W

660 Ft. from N. Line

Ft. from S. Line

330 Ft. from E. Line

Ft. from W. Line

SILICA POOL


Location \_\_\_\_\_

Rig up \_\_\_\_\_

Drilling and Remarks:

*Lane 3084**6" @ 3094**2000 acid**Depth. Pay 3270**May 3000**45° Gr.*

## RECORD

Cased \_\_\_\_\_ in., \_\_\_\_\_ ft.

Sand \_\_\_\_\_

Gas \_\_\_\_\_

Oil \_\_\_\_\_

Total Depth 3160

## PRODUCTION

1st 24 hrs. Nat. \_\_\_\_\_

1st 24 hrs. after shot \_\_\_\_\_

Gas \_\_\_\_\_ Cu. Ft.

Dry Hole \_\_\_\_\_

Abandoned \_\_\_\_\_

Date

DEC 11 1940 19

S. J. LEWIS Scout