

KANSAS


FORM 51 5M 4-41 PETROL

Rice

Section 16 Township 20 Range 10-W

Well No. #1-B Warner

Company Branine & Holl

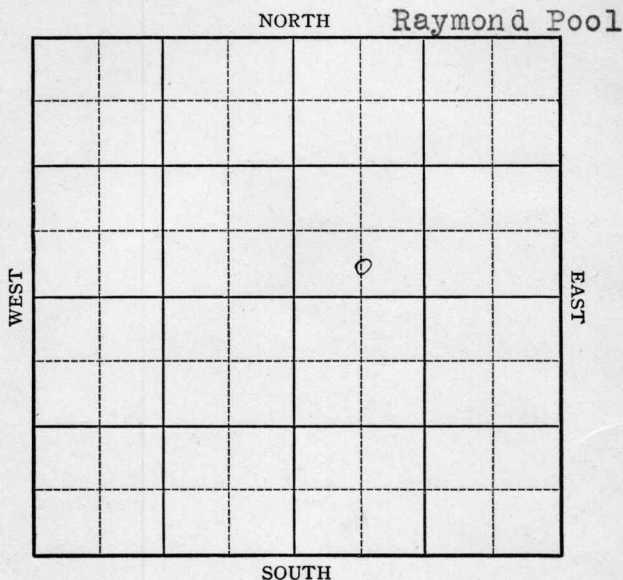


KANSAS

Rice

Sec. 16 Twp. 20 R. 10-WWell No. #1-B Warner FarmBranine & Holl Company
(Raymond) Ft. from N. Line330' Ft. from S. Line Ft. from E. Line660' Ft. from W. Line

Elev. 1831

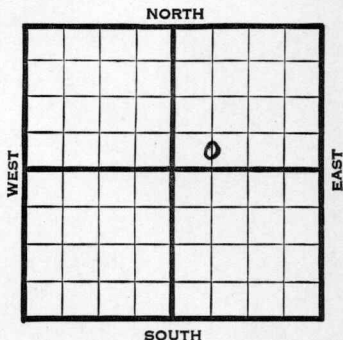

1941

REPORT

7/30

10" 216'

Anhy. 475'

Drlg. 1900'

8/7

" " "

8/15

7" 3133 Pay 3159-64

3000 acid swab 5 BOPH 3 hrs

No water

6000 more acid testing

8/21

" " " "

8/28

Shut down.

9/4

Lans. 3075'

Shut down.

9/11

" "

9/18

" "

9/24

Lans. 3075'

7" - 3133'

T.D. 3164'

9000 acid.

Potential 497 bbls., pump.

42.5 Gravity

COMPLETED

Map No. _____ Sec. 16 Twp. 20 R. 10WWell No. 1-B WarnerBranine & Holl

Company

Contractor

FIRST REPORT

C S L SW NE

SECTION PLAT

		0	

Ft. from N. Line

330

Ft. from S. Line

Ft. from E. Line

660

Ft. from W. Line

RAYMOND POOL

Location _____

Rig up _____

Drilling and Remarks:

10" - 216Anhy. 475Drlg. 1900

RECORD

Cased _____ in., _____ ft.

Sand _____

Gas _____

Oil _____

Total Depth _____

PRODUCTION

1st 24 hrs. Nat. _____

1st 24 hrs. after shot _____

Gas _____ Cu. Ft.

Dry Hole _____

Abandoned _____

Date

JUL 30 1941 19S. J. LEWIS Scout

Map No. A-46 Sec. 16 Twp. 20 R. 10WWell No. 1-B WarnerBranine & Holl CompanyCOMPLETED Contractor

C SL SW NE

SECTION PLAT

 Ft. from N. Line330 Ft. from S. Line Ft. from E. Line660 Ft. from W. Line

RAYMOND POOL

Location Rig up

Drilling and Remarks:

*Lane 3075**7" 3133**9000 acid**Pump 49788**425 gr*

RECORD

Cased in., ft.Sand Gas Oil Total Depth 3164

PRODUCTION

1st 24 hrs. Nat. 1st 24 hrs. after shot Gas 1 Cu. Ft.Dry Hole Abandoned

Date

SEP 24 1941 19S. J. LEWIS Scout