

Rice


KANSAS

Section 16 Township 20 Range 10-W

Well No. #1 Warner "C"

Company Holl & Braine

NORTH Raymond Pool

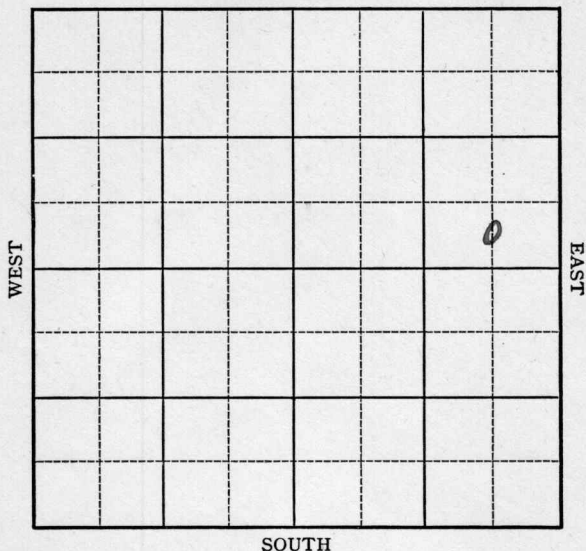

Rice

KANSAS


Map No. K-46 Sec. 16 Twp. 20 R. 10 WWell No. 1 Warner "C"Holl & Braine

Company

FIRST REPORT

Contractor

C SL SE NE

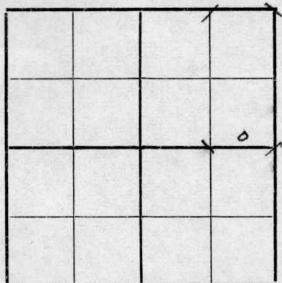SECTION PLAT Ft. from N. Line330 Ft. from S. Line660 Ft. from E. Line Ft. from W. Line

RAYMOND POOL

RECORDLocation Cased in., ft.Rig up Sand

Drilling and Remarks:

Gas Oil 10" - 216'Total Depth Drlg. 1350'**PRODUCTION**1st 24 hrs. Nat. 1st 24 hrs. after shot Gas Cu. Ft.Dry Hole Abandoned

Date

OCT 15 1941 19S. J. LEWIS

Scout

Map No. 46 Sec. 16 Twp. 20 R. 10WWell No. 1 Warner "C"Holl & Braine CompanyCOMPLETED Contractor

SECTION PLAT

C SL SE NE

 Ft. from N. Line330 Ft. from S. Line660 Ft. from E. Line Ft. from W. Line

RAYMOND POOL

Location Rig up

Drilling and Remarks:

Lease 88907' C 3105Flow Pa 4297Max 3000410 Ys

RECORD

Cased in., ft.Sand Gas Oil Total Depth 3124

PRODUCTION

1st 24 hrs. Nat. 1st 24 hrs. after shot Gas Cu. Ft.Dry Hole Abandoned

Date

DEC 3 1941 19S. J. LEWIS Scout