


Map No. 29 Sec. 16 Twp. 20 R. 10W
Well No. 29 Graham Farm Sinclair - Prairie Company

NORTH

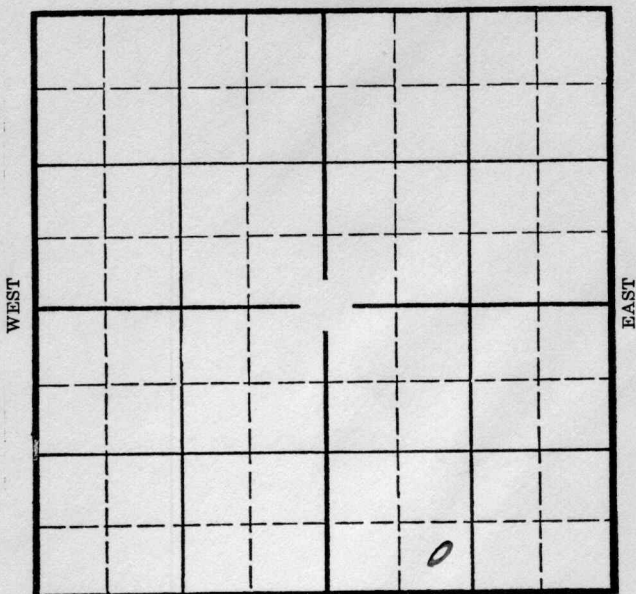

SOUTH

Location _____
Drilling Remarks _____

Rig Up _____
Drilling Remarks _____

RECORD

Cased _____ in. _____ ft.
Sand _____
Gas _____
Oil _____
Total Depth _____

PRODUCTION

1st 24 hrs. Nat. _____
1st 24 hrs. after shot _____
Gas _____ cu. ft. _____
Dry Hole _____
Abandoned _____

330 Ft. from S. Line

990 Ft. from W. Line


REPORT

10/30 Callan
11/7 Run Pot
11/14 Sdg 325 10" 164
11/21 " 2357
11/29 " 3305
12/6 7" 3339 Top Sil 3343
TD 3349 1500 Oil 4 hrs
Swabbing
12/11 Top Sil 3343
TD 3349
1000 acid
Pot 850 Oil

COMPLETED

Map No. 46 Sec. 16 Twp. 20 R. 10WWell No. 2- GrahamAmclair-Krause Company

Contractor

FIRST REPORTS

SECTION PLAT

Ft. from N. Line

330 Ft. from S. Line

Ft. from E. Line

990 Ft. from W. Line

Location

Rig up

Drilling and Remarks:

Cellar

RECORD

Cased.....in., ...ft.

Sand.....

Gas.....

Oil.....

Total Depth.....

PRODUCTION

1st 24 hrs. Nat.....

1st 24 hrs. after shot.....

Gas.....Cu. Ft.

Dry Hole.....

Abandoned.....

Date

10-30-35 192 ORVAL MANNSCHRECK Scout

KANSAS

Map No. 46 Sec. 16 Twp. 20 R. 10 W

Well No. 2 - Graham

Sinclair Prairie Company

Contractor

SECTION PLAT

			0

Ft. from N. Line

330 Ft. from S. Line

Ft. from E. Line

990 Ft. from W. Line

COMPLETED

Location

Rig up

Drilling and Remarks:

1000 acid

Pot 850 oil

RECORD

Cased in., ft.

Sand T Sil 3343

Gas

Oil

Total Depth 3349

PRODUCTION

1st 24 hrs. Nat.

1st 24 hrs. after shot

Gas Cu. Ft.

Dry Hole

Abandoned

Date

12-11-35 192

ORVAL MANNSCHRECK

Scout