

KANSAS


FORM 51 5M PETROL

Cowley

Section 24 Township 31 Range 4-E

Well No. #2 Deicham

Company Trees Oil

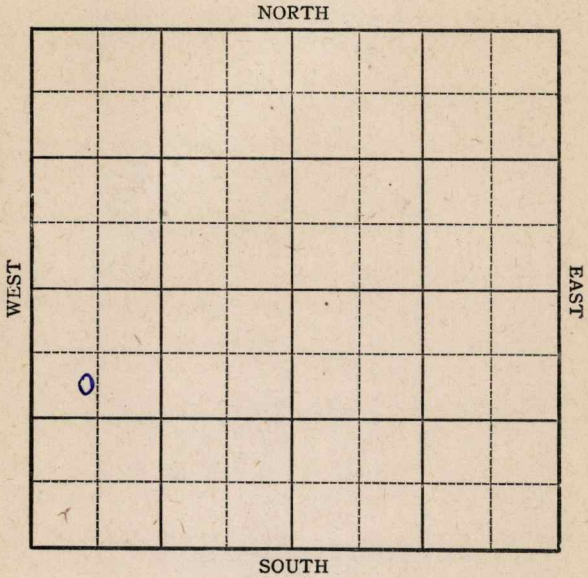

Sec. 24 Twp. 31 R. 4-E

Well No. #2 Deichman Farm

Trees Oil Company


990 Ft. from N. Line

_____ Ft. from S. Line

_____ Ft. from E. Line

560 Ft. from W. Line

Elev. 1202

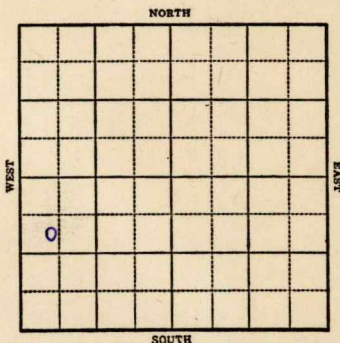

1943

R E P O R T

10/13 Location

10/20 Gable rig

10/27 15" @ 320'
Drlg. 340'

11/3 Drlg. 1200'

11/10 10" @ 1670
Fsg. 1890'

11/17 " "

11/24 " "

12/1 " "

12/8 Drlg. 1925'

12-15 Drlg. 2448'
8" at 2094'

12/22 Drlg. 2758
6" @ 2629

12/29 **Barb 2869-71**
TD SO & G
5" @ 2855 WOC

1944

1-5 TD 2911-80qts 2871-2911
CO

1/12 5" @ 2855
Bart 2869
Pump 642 Pot.
TD 2911
Gravity 39.6

COMPLETED

KANSAS

Map No. 3 Sec. 24 Twp. 31 R. 4E

Well No. 2 Deichman

Trees Oil Company

FIRST REPORT Contractor

C S L NW SW

SECTION PLAT

990 Ft. from N. Line

_____ Ft. from S. Line

_____ Ft. from E. Line

560 Ft. from W. Line

o			

Miscellaneous

Location X

Rig up _____

Drilling and Remarks:

RECORD

Cased _____ in., _____ ft.

Sand _____

Gas _____

Oil _____

Total Depth _____

PRODUCTION

1st 24 hrs. Nat. _____

1st 24 hrs. after shot _____

Gas _____ Cu. Ft.

Dry Hole _____

Abandoned _____

Date

OCT 13 1943 19

S. J. LEWIS Scout

KANSAS

Map No. 2 Sec. 24 Twp. 31 R. 4E

Well No. 2 Deichman

Trees Oil

Company

COMPLETED

Contractor

C S L NW SW

SECTION PLAT

990 Ft. from N. Line

_____ Ft. from S. Line

_____ Ft. from E. Line

560 Ft. from W. Line

Miscellaneous

Location _____

Rig up _____

Drilling and Remarks:

Bar 2869

5" @ 2855

Pump 642

39 6 9 1/2

RECORD

Cased _____ in., _____ ft.

Sand _____

Gas _____

Oil _____

Total Depth 2911

PRODUCTION

1st 24 hrs. Nat. _____

1st 24 hrs. after shot _____

Gas _____ Cu. Ft.

Dry Hole _____

Abandoned _____

Date

JAN 12 1944

19

S. J. LEWIS Scout