

KANSAS


FORM 51 5M 6-46 PETROL

Cowley county

Section 24 Township 31 Range 4-E

Well No. #3, Deitchmann

Company Trees Oil Company

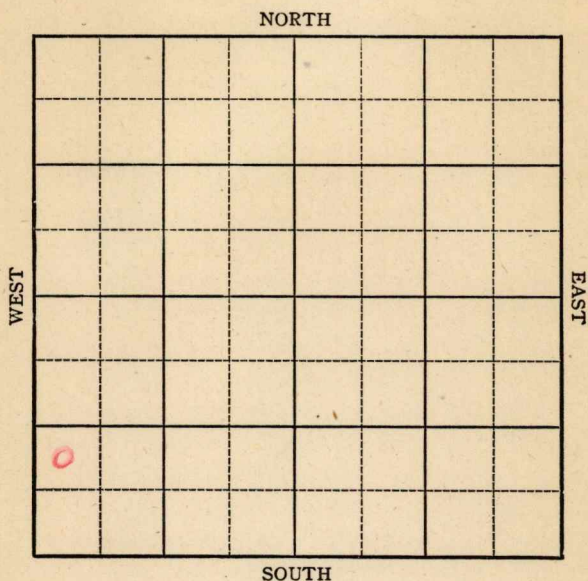

KANSAS

Cowley ✓

Sec. 24 Twp. 31 R. 4E

Well No. #3 Deitchmann Farm

Trees Oil Company

Miscellaneous


Ft. from N. Line

990 Ft. from S. Line

Ft. from E. Line

330 Ft. from W. Line

NW SW SW

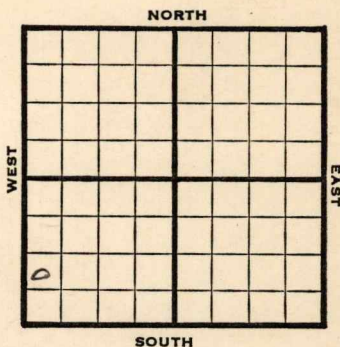

1946

Elev. 1198'

REPORT

10/16 Rig
10/22 Spud
10/29 13" @ 318'
Drlg 640'
11/6 12" @ 1215'
Drlg 1430'
11/12 10" @ 1565'
Drlg 1645'
11/20 10" @ 1640'
Drlg 1983'
11/27 Drlg 2400'
12/3 8" @ 2070'
6" @ 2641
Drlg 2665'
12/11 Miss 2933'
TD 2935'

ABANDONED

Kansas

KANSAS

Map No. 2 Sec. 24 Twp. 31 R. 4EWell No. 3 DeitchmannTrees Oil CompanyFIRST REPORT Contractor

NW SW SW

SECTION PLAT

0			

 Ft. from N. Line990 Ft. from S. Line Ft. from E. Line330 Ft. from W. Line

Cowley County

Location Rig up

Drilling and Remarks:

Rig

RECORD

Cased in., ft.Sand Gas Oil Total Depth

PRODUCTION

1st 24 hrs. Nat. 1st 24 hrs. after shot Gas Cu. Ft.Dry Hole Abandoned

Date

OCT 16 1946 19

S. J. LEWIS

Scout

KANSAS

Map No. _____ Sec. 24 Twp. 31 R. 4E

Well No. 3 Deitchmann

Tree Oil Company

ABANDONED

Contractor

NW SW SW

E1, 1198
SECTION PLAT

<i>6</i>			

_____ Ft. from N. Line

990 Ft. from S. Line

_____ Ft. from E. Line

330 Ft. from W. Line

Cowley County

Location _____

Rig up _____

Drilling and Remarks:

Miss 2938

RECORD

Cased _____ in., _____ ft.

Sand _____

Gas _____

Oil _____

Total Depth 2225

PRODUCTION

1st 24 hrs. Nat. _____

1st 24 hrs. after shot _____

Gas _____ Cu. Ft.

Dry Hole _____

Abandoned _____

Date

DEC 1 1 1946

19

S. J. LEWIS

Scout

2