

KANSAS

Rice


FORM 51 5M 4-41 PETROL

Section 16 Township 20 Range 10-W

Well No. 3 Graham

Company Störmfeltz & Hyde

NORTH Raymond Pool

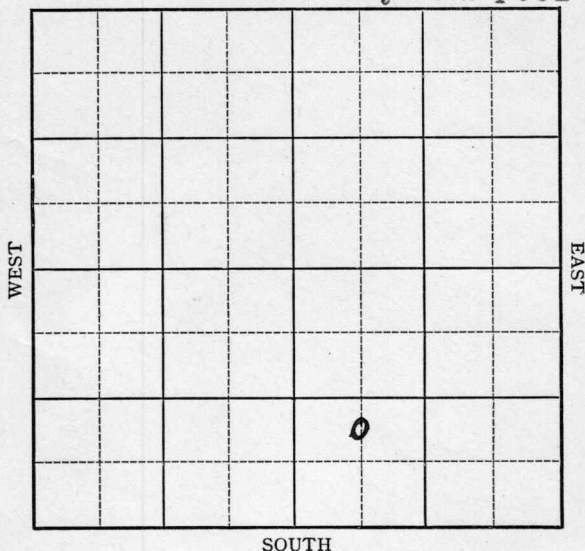

KANSAS


Rice

Sec. 16 Twp. 20 R. 10-WWell No. #3 Graham FarmStormfeltz & Hyde Company

(Raymond)

 Ft. from N. Line990 Ft. from S. Line Ft. from E. Line660 Ft. from W. Line

Elev. 1818

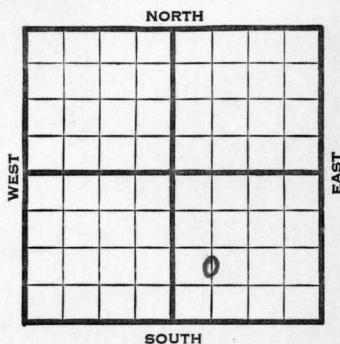

1941

REPORT

8/27 Derrick.

9/4 10" - 165' Drlg. 1110'

9/11 Lans. ~~3076~~³⁰⁸⁰ Drlg. 3097'

9/18 Shut down.

9/25 Lans. 3080' (Corrected)

7" - 3126' T.D. 3129' RUST.

10/1 Lans. 3080'

7" - 3126'

T.D. 3211'

2000 acid.

Pump 103 oil & 144 water

42.5 Gravity

COMPLETED

Map No. _____ Sec. 16 Twp. 20 R. 10WWell No. 3 GrahamStormfeltz & Hyde CompanyFIRST REPORT Contractor

SECTION PLAT

C N L SW SE

_____ Ft. from N. Line

990 Ft. from S. Line

_____ Ft. from E. Line

660 Ft. from W. Line

RAYMOND POOL

Location _____

Rig up _____

Drilling and Remarks:

Derrick

RECORD

Cased _____ in., _____ ft.

Sand _____

Gas _____

Oil _____

Total Depth _____

PRODUCTION

1st 24 hrs. Nat. _____

1st 24 hrs. after shot _____

Gas _____ Cu. Ft.

Dry Hole _____

Abandoned _____

Date

AUG 27 1941

19

S. J. LEWIS

Scout

KANSAS

Map No. K-46 Sec. 16 Twp. 20 R. 10WWell No. 3 GrahamStormfeltz & Hyde

Company

COMPLETED

Contractor

C NL SW SE

SECTION PLAT

Ft. from N. Line

990 Ft. from S. Line

Ft. from E. Line

660 Ft. from W. Line

RAYMOND POOL

Location

Rig up

Drilling and Remarks:

Lane 30807" @ 32262000 acidPump 103 oil 144 McWP. F.425/4

RECORD

Cased _____ in., _____ ft.

Sand _____

Gas _____

Oil _____

Total Depth 3211

PRODUCTION

1st 24 hrs. Nat. _____

1st 24 hrs. after shot _____

Gas _____ Cu. Ft.

Dry Hole _____

Abandoned _____

Date

OCT 1 1941 19S. J. LEWIS

Scout