


Section 24 Township 31 Range 4E

Well No. #6 Deichman

Company Trees Oil Co.

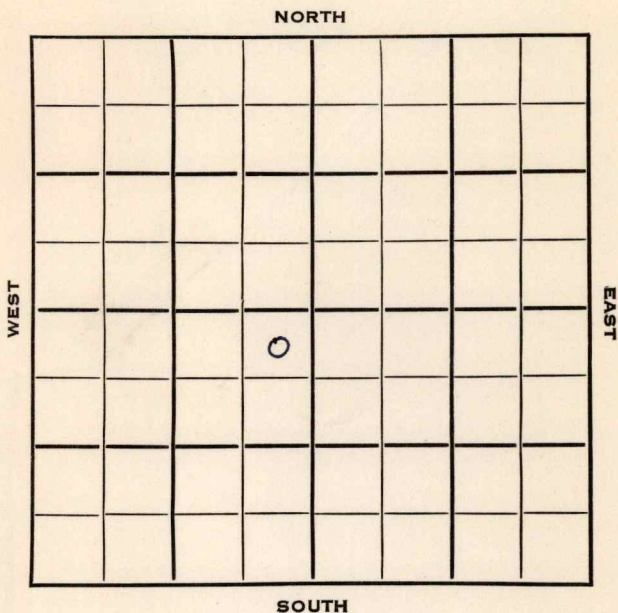

Sec. 24 Twp. 31 R. 4E

Well No. #6 Deichman Farm

Trees Oil Co. Company

Watson Contractor

Deichman Pool


330 Ft. from N. Line

_____ Ft. from S. Line

330 Ft. from E. Line

_____ Ft. from W. Line

NE NE SW

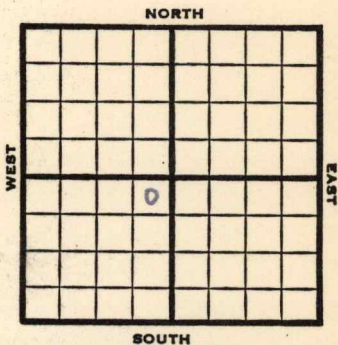

1953

Elev. 1183' REPORT

8/19

Spud 8-13-53
Drlg. 1800'

10/7

Spud 8-13-53
Oil Well
TD 2837'
8" @ 100'
KC 2295, Bart 2804,
TD 2837'
5" @ 2804'
CO to 2837 wtr.
PB2812
sd-frac
Comp 45 bopd.

COMPLETED

County **Cowley** State **Kansas**

Sec. **24** (Blk. **31**) (Sur. **4E**) (Twp.) (Rge.) Map No.

Operator **Trees Oil Co.**

Well No. **6** Farm **Deichman**

Elev. Location **NE NE SW**

FIRST REPORT									

330 Ft. From **N** Line **SW**

330 Ft. From **E** Line **Quarter**

1st. Report **AUG 19 1953**

Completion

Remarks

Watson - Contr.

Spudding Date **8-13-53**

Drlg. Data **Deichman Pool**

drlg. 1800

J. G. McGEHEE

