

KANSAS


Rice

FORM 51 5M 4-41 PETROL

Section 17 Township 20 Range 10-W

Well No. #1 Poscin

Company Benson Drilling

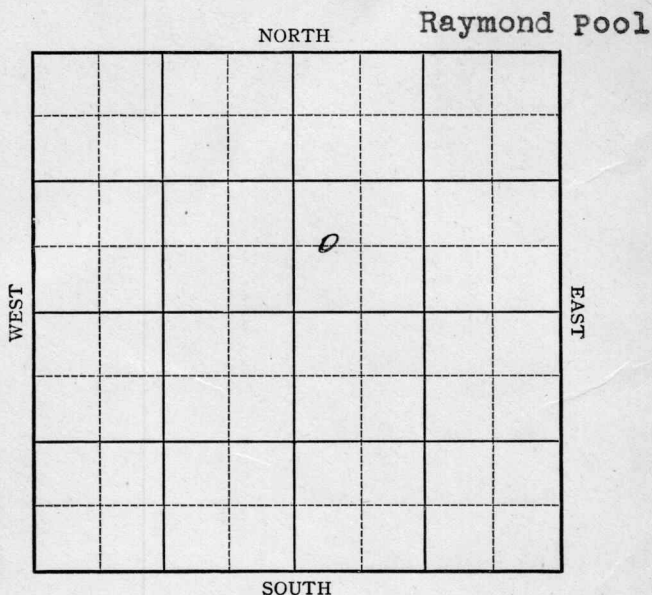

KANSAS


Rice

Sec. 17 Twp. 20 R. 10-WWell No. #1 Poscin FarmBenson Drilling Company

(Raymond)

 Ft. from N. Line660 Ft. from S. Line Ft. from E. Line330 Ft. from W. Line

Elev. 1797

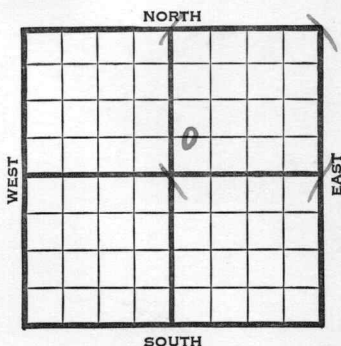

	REPORT
1941	
4/23	Cable.
5/1	15" - 85' 12" - 465'
	Drlg. 1035'
5/8	10" - 1475' Drlg. 1930'
5/15	2350' U.R. 8".
5/22	8" - 2388' Drlg. 2790'
5/28	6" - 2983' Drlg. 3075'
6/4	Arb. 3361'
	T.D. 3368'
	Water.
	ABANDONED

Map No. 46 Sec. 17 Twp. 20 R. 10WWell No. 1 Poscin

Benson Drilling

Company

FIRST REPORT

Contractor

C W L SW NE


Ft. from N. Line

660 Ft. from S. Line

Ft. from E. Line

330 Ft. from W. Line

SECTION PLAT

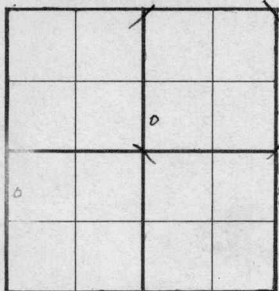

RAYMOND POOL

Location _____

Rig up _____

Drilling and Remarks:

Cable

RECORD

Cased _____ in., _____ ft.

Sand _____

Gas _____

Oil _____

Total Depth _____

PRODUCTION

1st 24 hrs. Nat. _____

1st 24 hrs. after shot _____

Gas _____ Cu. Ft.

Dry Hole _____

Abandoned _____

Date

APR 22 1941 19

S. J. LEWIS

Scout

Map No. 46 Sec. 17 Twp. 20 R. 10WWell No. 1 Poscin

Benson Drilling Company

ABANDONED

Contractor

C W L SW NE

Ft. from N. Line

660 Ft. from S. Line

Ft. from E. Line

330 Ft. from W. Line

RAYMOND POOL

SECTION PLAT

		o	

Location _____

Rig up _____

Drilling and Remarks:

*Ar 8361**Water*

RECORD

Cased _____ in., _____ ft.

Sand _____

Gas _____

Oil _____

Total Depth 3368

PRODUCTION

1st 24 hrs. Nat. _____

1st 24 hrs. after shot _____

Gas _____ Cu. Ft.

Dry Hole _____

Abandoned _____

Date

JUN 4 1941S. J. LEWIS Scout