

KANSAS


Cowley

FORM 51 5M PETROL

Section 24 Township 31 Range 4E

Well No. 2 Gibson

Company Trees Oil

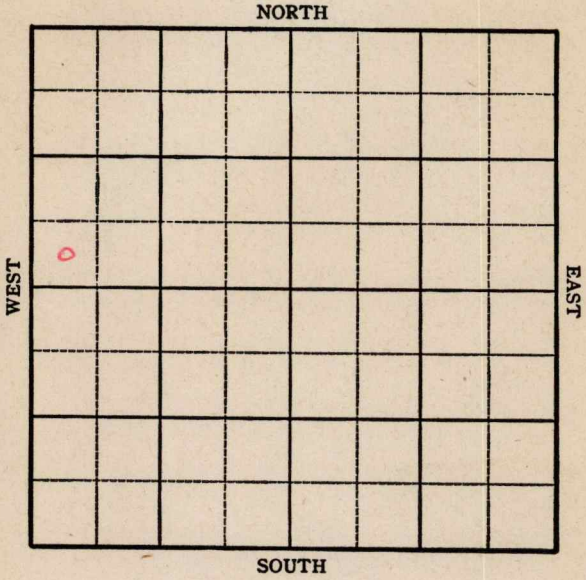

Sec. 24 Twp. 31 R. 4-E


Well No. #2 Gibson Farm \_\_\_\_\_  
Trees Oil Company \_\_\_\_\_

\_\_\_\_\_ Ft. from N. Line

330 Ft. from S. Line

\_\_\_\_\_ Ft. from E. Line

330 Ft. from W. Line

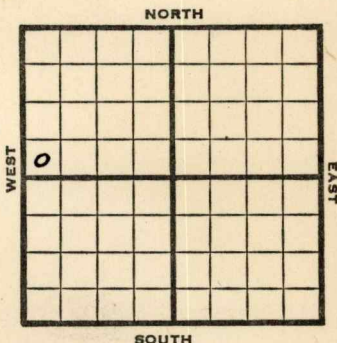

SW NW

**1945 Elev. 1227** REPORT

11/7 Location

- 11/14 "
- 11/21 Derrick
- 11/28 Drlg. 100
- 12;5 15" @ 345  
Drlg. 850'
- 12/12 Drlg. 1470  
12" @ 1250
- 12/20 1670' UR 10".
- 12/29 Drlg. 1900'
- 1946
- 1/10 Drlg. 2200'
- 1/17 Fsg 2502'
- 1/24 8" - 2100' K.C. 2290'  
6" - 2616' Drlg. 2703'
- 1/31 **Bart 2900'** 5" - 2890'  
T.D. 2944' SO.
- 2/7 " "
- 2/14 " "
- 2/20 P.B. to 2938'
- 2/28 Shot 100 qts.  
C. O.
- 3/7 "
- 3/13 **Bart. 2900**  
5" @ 2885  
100 qts.  
TD 2945  
Pump 40 Pot.  
Grav. 36.0

**COMPLETED**

**KANSAS**

Kansas Pool Name Miscellaneous

Map No. 2 Sec. 24 Twp. 31 R. 4E

Well No. 2 Gibson

Trees Oil

Company \_\_\_\_\_

**FIRST REPORT**

Contractor \_\_\_\_\_

SW NW

**SECTION PLAT**

\_\_\_\_\_ Ft. from N. Line

330 Ft. from S. Line

\_\_\_\_\_ Ft. from E. Line

330 Ft. from W. Line

o			

Cowley County

Location x

Rig up \_\_\_\_\_

Drilling and Remarks:

**RECORD**

Cased \_\_\_\_\_ in., \_\_\_\_\_ ft.

Sand \_\_\_\_\_

Gas \_\_\_\_\_

Oil \_\_\_\_\_

Total Depth \_\_\_\_\_

**PRODUCTION**

1st 24 hrs. Nat. \_\_\_\_\_

1st 24 hrs. after shot \_\_\_\_\_

Gas \_\_\_\_\_ Cu. Ft.

Dry Hole \_\_\_\_\_

Abandoned \_\_\_\_\_

Date

NOV 7 1945 19

S. J. LEWIS

Scout

**KANSAS**

Kansas

Pool Name Miscellaneous

Map No. 2 Sec. 24 Twp. 31 R. 4E

Well No. 2 Gibson

Trees Oil Company

**COMPLETED**

Contractor

SW NW

*E11229*  
**SECTION PLAT**

\_\_\_\_\_ Ft. from N. Line

330 Ft. from S. Line

\_\_\_\_\_ Ft. from E. Line

330 Ft. from W. Line

0			

Cowley County

Location \_\_\_\_\_

Rig up \_\_\_\_\_

Drilling and Remarks:

*Bar 42900*

*5' @ 2585'*

*100%*

*Pump 40 PD*

*360 Gr*

**RECORD**

Cased \_\_\_\_\_ in., \_\_\_\_\_ ft.

Sand \_\_\_\_\_

Gas \_\_\_\_\_

Oil \_\_\_\_\_

Total Depth 2945'

**PRODUCTION**

1st 24 hrs. Nat. \_\_\_\_\_

1st 24 hrs. after shot \_\_\_\_\_

Gas \_\_\_\_\_ Cu. Ft.

Dry Hole \_\_\_\_\_

Abandoned \_\_\_\_\_

Date

MAR 13 1946

19

**S. J. LEWIS** Scout