


Cowley **KANSAS**

SECTION 24 TOWNSHIP 31 RANGE 4 E

WELL NO. #2 Gibson

COMPANY H. H. Blair

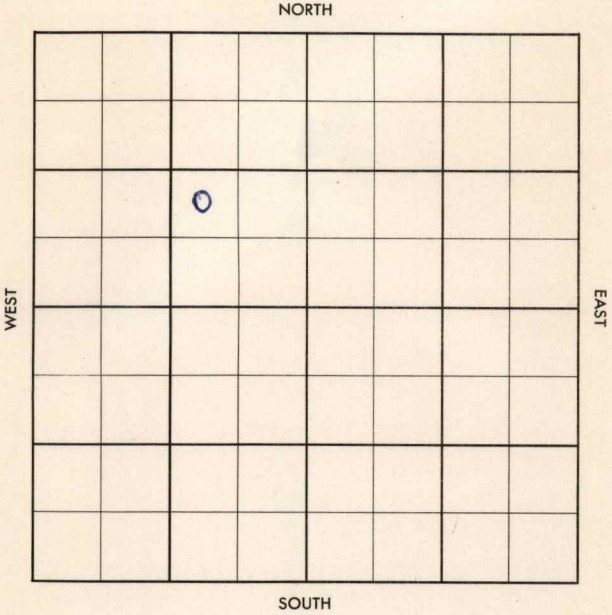

Cowley

KANSAS


SEC.	24	TWP.	31	R.	4E
------	----	------	----	----	----

WELL NO. #2 Gibson FARM

COMPANY H. H. Blair

CONTRACTOR Bedell & Catt
Deichman

_____ Ft. from N. Line
 _____ Ft. from S. Line
 _____ Ft. from E. Line
 _____ Ft. from W. Line

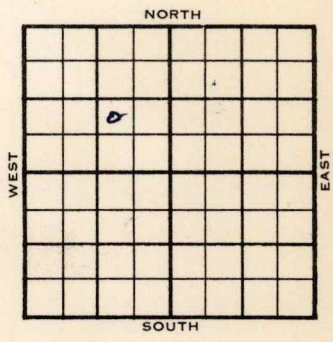

NW SE NW

	ELEVATION	REPORT
1955	1212	
11/9	8" @ 100 RURT	
12-7	Comm. 11-7-55 8 5/8" @ 70/60 5 1/2" @ 2963 CO to 2930 24/ 2900-06 frac, Comp. 25 bopd, 10% wtr. Layton 2265 Bart 2802 1st sd 2804-96 2nd sd. 2896-2912 TD 2966	

COMPLETED

County Cowley Elev. _____
 Sec. 24 Twp. 31 Rge. 4E
 Company H. H. Blair
 Farm Name Gibson No. 2

TOPS	DEPTH	LOG	DATUM
Anh.			
Tp.			
H.			
Tr.			
Dg.			
Bl.			
L.			
K.C.			
B.K.C.			
Ce.			
C.			
M.			
M.			
K.			
Mz.			
Mq.			
V.			
S.			
S.			
A.			
R.			
Pe.			
G.			
T.D.			

Loc. in Sec. NW SE NW
 Geol. _____
 Contr. Bedell & Cat
 Pool Deichman
 0
 NOV 9 '55
 FIRST REPORT

Date Comm. 8th @ 100 RURT

Co.
No.
Sec.
T.
R.

County Cowley Elev. 1212
 Sec. 24 Twp. 31 Rge. 4E
 Company H. H. Blair
 Farm Name Gibson No. 2

TOPS	DEPTH	LOG	DATUM
Anh.			
T.P. <u>Layton</u>	<u>2265</u>		<u>1053</u>
H.			
Tr.			
Dg. <u>Bark</u>	<u>2802</u>		<u>1590</u>
B.L.			
L. <u>1st sd</u>	<u>2804-96</u>		<u>1592</u>
K.C. <u>2nd "</u>	<u>2896-2912</u>		<u>1684</u>
B.K.C.			
Ce.			
C.			
M.			
M.			
K.			
Mz.			
Me.			
V.			
S.			
S.			
A.			
R.			
PE.			
G.			
T.D.	<u>2966</u>		

Loc. in Sec. NW SE NW
 Geol. _____
 Contr. _____
 Bedell & Cat
 Pool
 Deichman



Date Comm. 11-7-55 DEC 7 1955
8 5/8" @ 70/60 5 1/2" @ 2963 CO to 2930
24/ 2900-06 frac Comp. 25 bopd 10% wt

Co. No. T. R.