

Cowley


KANSAS

SECTION 25 TOWNSHIP 31 RANGE 4 E

WELL NO. #1 Bender

COMPANY McKnab & Lindsay & Trees

NORTH

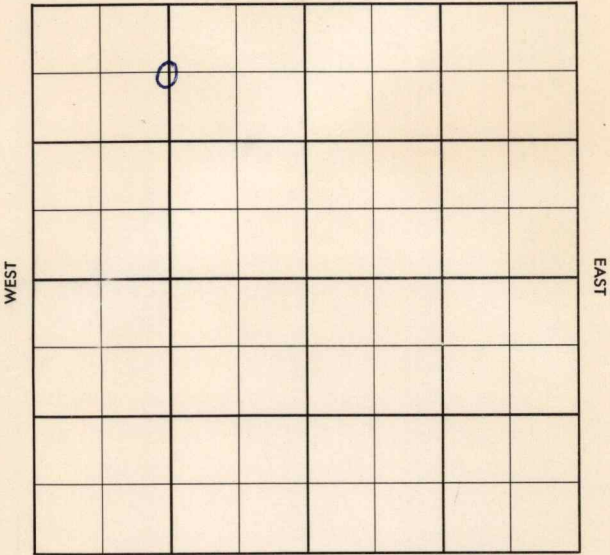

SOUTH

SEC.

25

TWP.

31

R.

4E

WELL NO.

#1 Bender

FARM

COMPANY

McKnab & Lindsay & Trees

CONTRACTOR

Co. Tools


\_\_\_\_\_ Ft. from N. Line

\_\_\_\_\_ Ft. from S. Line

\_\_\_\_\_ Ft. from E. Line

\_\_\_\_\_ Ft. from W. Line

C NL NW/4

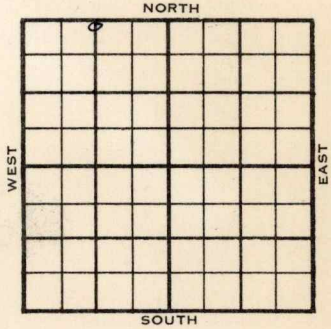

	ELEVATION	REPORT
1956	1176'	
1-11	10" @ 158 Drlg. 1000	
1-18	DST 2872-78 op 20 min. rec 8' mud, 26/20" D & A Layton 2249 KC 2305 Owsego 2697 Cattleman 2786 Bart 2871 M. 2919 TD 2922'	

**ABANDONED**

County Cowley Elev. \_\_\_\_\_  
 Sec. 25 Twp. 31 Rge. 4E  
 Company McKnab & Lindsay & Trees  
 Farm Name Bender No. 1

TOPS	DEPTH	LOG	DATUM	Loc. in Sec.	
Anh.				C NL NW/4	
Tr.					
H.					
Tr.					
Dg.					
B.L.					
L.					
K.C.					Geol. _____
B.K.C.					Contr. _____
Ce.					Co. tools
C.					
M.					
M.				Pool	
K.					
Mz.					
Me.					
V.					
S.					
S.					
A.					
R.					
Pe.					
G.					
T.D.					

0  
 JAN 11 '58  
 FIRST REPORT

Date Comm. 10" @ 158 drlg. 1000

---



---



---



---



---



---



---



---



---



---

Co.  
Lse.  
No.  
Sec.  
T.  
R.

County Cowley Elev. 1176  
 Sec. 25 Twp. 31 Rge. 4E  
 Company McKnab & Lindsay & Trees  
 Farm Name Bender No. 1

TOPS	DEPTH	LOG	DATUM
Anh.			
TP.			
H.			
Tr.			
Dg.			
BL.			
L. <u>Layton</u>	<u>2249</u>		<u>1073</u>
K.C.	<u>2365</u>		<u>1129</u>
B.K.C. <u>Carney</u>	<u>2697</u>		<u>1521</u>
Ce. <u>Cattley</u>	<u>2786</u>		<u>1610</u>
C. <u>Bart</u>	<u>2871</u>		<u>1695</u>
M.	<u>2919</u>		<u>1743</u>
K.			
Mz.			
Mq.			
V.			
S.			
S.			
A.			
R.			
PE.			
G.			
T.D.	<u>2922</u>		

Loc. in Sec. C NL NW/4  
 Geol. \_\_\_\_\_  
 Contr. \_\_\_\_\_  
 Co. tools \_\_\_\_\_  
 Pool \_\_\_\_\_



Date Comm. JAN 1 8 1956

10" @ 158 DST 2872-78 open 20 min.

rec. 8' mud 26/20"

D & A

D.R.

Co.  
No.  
Sec.  
T.  
R.