

KANSAS


Rice

FORM 51 5M 4-41 PETROL

Section 17 Township 20 Range 10W

Well No. #2 Thompson

Company Braine & Holl

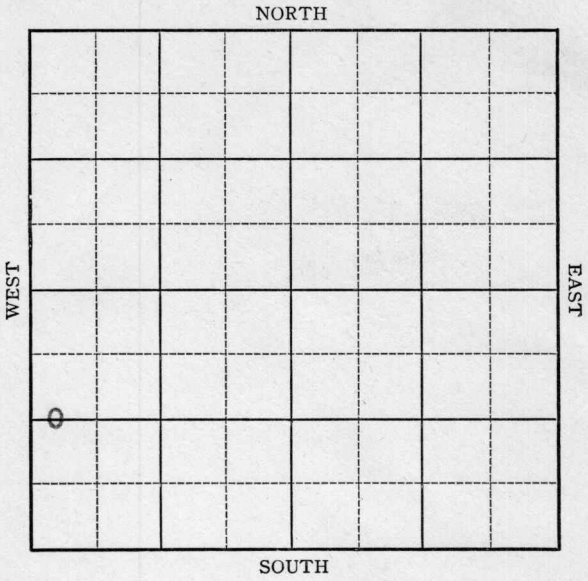

Map No. _____ Sec. 17 Twp. 20 R. 10WWell No. 2 Thompson_____ Braine & Holl _____ Company

_____ Contractor

FIRST REPORT

C WL SW

_____ Ft. from N. Line

1320 Ft. from S. Line

_____ Ft. from E. Line

330 Ft. from W. Line

RAYMOND POOL

SECTION PLAT

Location _____

Rig up _____

Drilling and Remarks:

10" @ 205Drilling 2340

RECORD

Cased _____ in., _____ ft.

Sand _____

Gas _____

Oil _____

Total Depth _____

PRODUCTION

1st 24 hrs. Nat. _____

1st 24 hrs. after shot _____

Gas _____ Cu. Ft.

Dry Hole _____

Abandoned _____

Date

SEP 10 1941 19S. J. LEWIS Scout

Rice

KANSAS

Map No. K-46 Sec. 17 Twp. 20 R. 10W

Well No. 2 Thompson

Braine & Holl Company

ABANDONED Contractor

C WL SW

SECTION PLAT

Ft. from N. Line

1320 Ft. from S. Line

Ft. from E. Line

330 Ft. from W. Line

RAYMOND POOL

Location _____

Rig up _____

Drilling and Remarks:

*Lease 3060
5" C 9135
A P W.*

RECORD

Cased _____ in., _____ ft.

Sand _____

Gas _____

Oil _____

Total Depth 3135

PRODUCTION

1st 24 hrs. Nat. _____

1st 24 hrs. after shot _____

Gas _____ Cu. Ft.

Dry Hole _____

Abandoned _____

Date

OCT 8 1941 19

S. J. LEWIS Scout