


Map No. KANSAS Sec. 16 Twp. 20 R. 10-WWell No. #4 Graham Farm
Sinclair-Prairie Company

NORTH

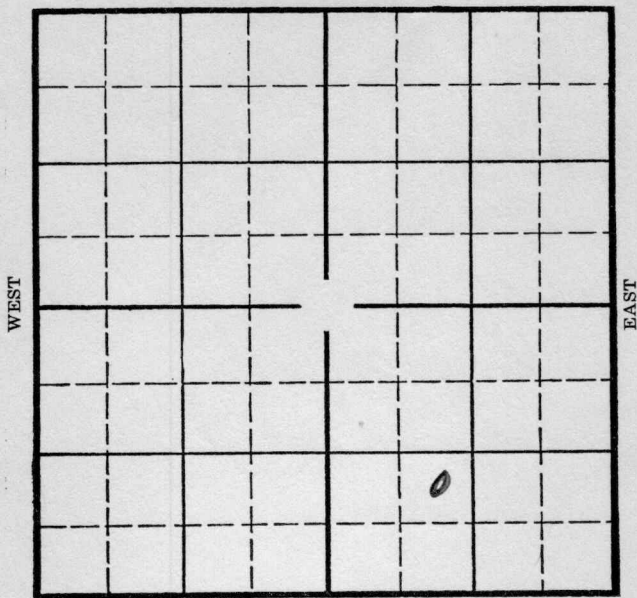

SOUTH

Location _____

Drilling Remarks _____

Rig Up _____

Drilling Remarks _____

RECORD

Cased _____ in. _____ ft.

Sand _____

Gas _____

Oil _____

Total Depth _____

PRODUCTION

1st 24 hrs. Nat. _____

1st 24 hrs. after shot _____

Gas _____ cu. ft. _____

Dry Hole _____

Abandoned _____

RICE.

Map No. Sec. 16 Twp. 20 R. 10W

Well No. #4 Graham Farm


Sinclair-Prairie Company

 Ft. from N. Line

990' Ft. from S. Line

 Ft. from E. Line

990' Ft. from W. Line

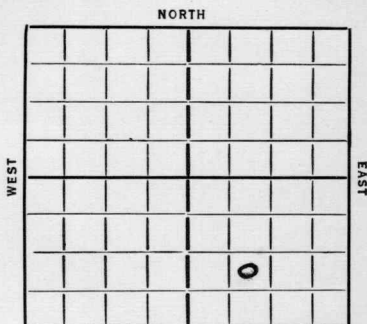

Elev. 1817

Date 1936

REPORT

3/25 Ponds

4/2 12"-166' T.D. 195' WOC.

4/10 Drlg. 1880'

4/16 Drlg. 2040'

4/23 7" @ 3357'. Sil. 3357½'

4/30 T.D. 3365'. ½ BBLS. per hour.

5/7 2000' water 3361-69'. T.D.

5/14 Shut down.

5/21--5/28--

6/3/36-P.B. 2352'. lost hole.

T.D. 3369'.

D & A

ABANDONED

KANSAS

Map No. 46 Sec. 16 Twp. 20 R. 10 W.Well No. 4 GrahamSinclair Prairie Company


Contractor

SECTION PLAT

.....Ft. from N. Line

990 Ft. from S. Line

.....Ft. from E. Line

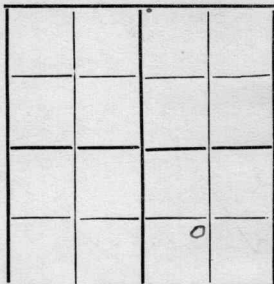990 Ft. from W. Line

FIRST REPORTS

Location.....

Rig up.....

Drilling and Remarks:

Pond

RECORD

Cased.....in., ...ft.

Sand.....

Gas.....

Oil.....

Total Depth.....

PRODUCTION

1st 24 hrs. Nat.....

1st 24 hrs. after shot.....

Gas.....Cu. Ft.

Dry Hole.....

Abandoned.....

Date

3/25/26 192.....

S. J. LEWIS

Scout

Map No. 46 Sec. 16 Twp. 20 R. 10 WWell No. 4 GrahamSinclair-Prairie Company

Contractor

SECTION PLAT

_____ Ft. from N. Line

990 Ft. from S. Line

_____ Ft. from E. Line

990 Ft. from W. Line

ABANDONED

Location _____

RECORD

Cased _____ in., _____ ft.

Sand _____

Gas _____

Oil _____

Total Depth 3369

PRODUCTION

1st 24 hrs. Nat. _____

1st 24 hrs. after shot _____

Gas _____ Cu. Ft.

Dry Hole _____

Abandoned _____

Date

JUN 3 1936

S. J. LEWIS

Scout