

KANSAS


FORM 51 5M 11-44 PETROL

Cowley County

Section 24 Township 31 Range 4E

Well No. #1 T. W. Dicken

Company B. B. Blair

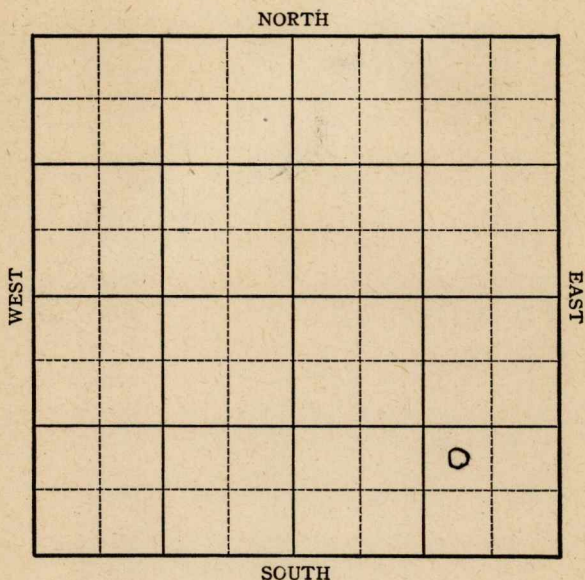

KANSAS

Cowley county

Sec. 24 Twp. 31 R. 4E

Well No. #1, T.W. Dicken Farm

B.B. Blair Company


Miscellaneous

 Ft. from N. Line

990 Ft. from S. Line

990 Ft. from E. Line

 Ft. from W. Line

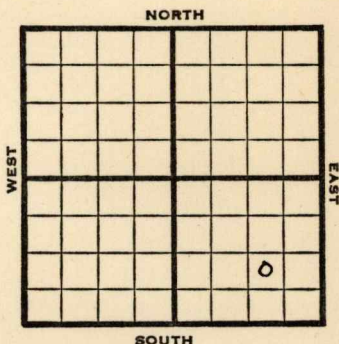

NW SE SE

Elev. 1194

REPORT

1946

6/12

RUR

6/18

10" @ 60'

Drlg 1600'

6/26

Drlg 2800'

7/3

Bart 2832

Miss 2919

TD 2932'

ABANDONED


KANSASKansas Pool Name MiscellaneousMap No. 2 Sec. 24 Twp. 31 R. 4EWell No. 1 T. W. DickenB. B. Blair

Company

FIRST REPORT

Contractor

NW SE SE

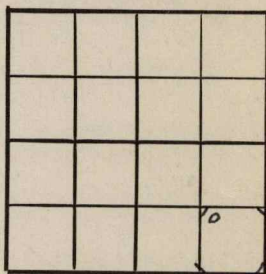SECTION PLAT Ft. from N. Line990 Ft. from S. Line990 Ft. from E. Line Ft. from W. LineCowley CountyLocation Rig up

Drilling and Remarks:

RUR**RECORD**Cased in., ft.Sand Gas Oil Total Depth **PRODUCTION**1st 24 hrs. Nat. 1st 24 hrs. after shot Gas Cu. Ft.Dry Hole Abandoned

Date

JUN 12 194619S. J. LEWISScout

KANSASKansas Pool Name MiscellaneousMap No. 2 Sec. 24 Twp. 31 R. 4EWell No. 1 T. W. DickenB. B. Blair

Company

ABANDONED

Contractor

NW SE SE

2/1/194
SECTION PLAT

			0

Ft. from N. Line990Ft. from S. Line990Ft. from E. LineFt. from W. LineCowley County

Location

Rig up

Drilling and Remarks:

Bar 72832
Miss 2919**RECORD**

Cased _____ in., _____ ft.

Sand _____

Gas _____

Oil _____

Total Depth 2982**PRODUCTION**

1st 24 hrs. Nat. _____

1st 24 hrs. after shot _____

Gas _____ Cu. Ft.

Dry Hole _____

Abandoned _____

Date

JUL 3 1946 19S. J. LEWIS

Scout