


KANSAS

Section 17 Township 20 Range 10-W
Well No. ~~#2~~ #1 Massman
Company Branine & Hall

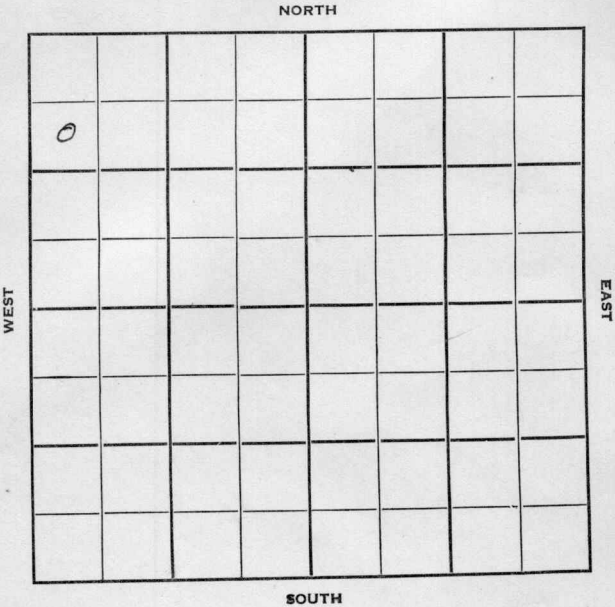

O. W. D. D

KANSAS

Rice

Sec. 17 Twp. 20 R. 10-W

Well No. #1 Massman Farm

Branine & Hall Company

Contractor

Raymond

990

Ft. from N. Line

Ft. from S. Line


Ft. from E. Line

330

Ft. from W. Line

SW NW NW

O. W. D. D

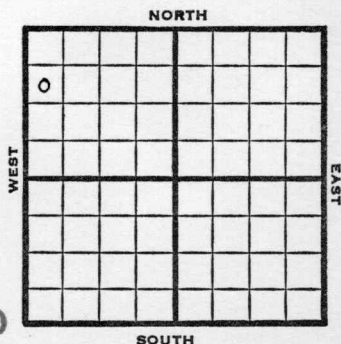

1950

Elv 1793

REPORT

6/7

Spud 6-1-50

8 5/8 @ 187

Dr1g. 2655

7/12

8 5/8" @ 187

Topeka 2634

Dodge 2917

Lans 3058

SO 3134-43

B KC 3301

5" @ 3331

32/3134-43

D&A

Heeb 2900

Br lime 3026

Arb 3330-31

ABANDONED

O. W. D. D

7/19

abd 3331

DD 3342

S/1/2 boph

1000 acid

S/14 boph

5 bwph

3350-59 TD

TD 3359

D&A

FIRST REPORT

ABANDONED

Map No. _____ Sec. 17 Twp. 20 R. 10WWell No. 1 MassmanBranine & Hall Company_____
Contractor

SW NW NW

SECTION PLAT

990 Ft. from N. Line

_____ Ft. from S. Line

_____ Ft. from E. Line

330 Ft. from W. LineRice

Location _____

Rig up _____

Drilling and Remarks:

Spud 6-1-50

8 5/8 @ 187

Drlg. 2655

RECORD

Cased _____ in., _____ ft.

Sand _____

Gas _____

Oil _____

Total Depth _____

PRODUCTION

1st 24 hrs. Nat. _____

1st 24 hrs. after shot _____

Gas _____ Cu. Ft.

Dry Hole _____

Abandoned _____

Date

JUN 7 1950 19J. E. TYRA Scout

Map No. _____ Sec. 17 Twp. 20 R. 10WWell No. 1 MassmanBranine & Hall

Company

Contractor

SW NW NW

E1. 1793

SECTION PLAT

990 Ft. from N. Line

_____ Ft. from S. Line

_____ Ft. from E. Line

330 Ft. from W. Line

Rice County



Location _____

Rig up _____

Drilling and Remarks:

8 5/8" @ 187

Topeka 2634

Heeb. 2900

Dodge 2917

Br. lime 3026

Lans. 3053

RECORD

Cased _____ in., _____ ft.

Sand _____

Gas _____

Oil _____

Total Depth 3331

PRODUCTION

1st 24 hrs. Nat. _____

1st 24 hrs. after shot _____

Gas _____ Cu. Ft.

Dry Hole _____

Abandoned _____

Date

JUL 12 1950

19

J. E. TYRA

Scout

SO 3134-43

B KC 3301

Arb. 3330-31

5" @ 3331

32/ 3134-43

D & A

JUL 1 1950

Scout Cards
Land Small Map
Land Wall Map
Tracings
France Map
Pierce Map
Misc.



















Kansas

Raymond Pool

Map No. _____ Sec. 17 Twp. 20 R. 10WWell No. 2 Massman

O. W. D. D

Branine & Hall

Company

CORRECTION

Contractor

SW NW NW

E1. 1793
SECTION PLAT990 Ft. from N. Line

_____ Ft. from S. Line

_____ Ft. from E. Line

330 Ft. from W. Line

0			

Rice County

Location _____

Rig up _____

Drilling and Remarks:

Completed

July 12, 1950

as #1 Massman

RECORD

Cased _____ in., _____ ft.

Sand _____

Gas _____

Oil _____

Total Depth _____

PRODUCTION

1st 24 hrs. Nat. _____

1st 24 hrs. after shot _____

Gas _____ Cu. Ft.

Dry Hole _____

Abandoned _____

Date

JUL 26 1950 19

J. E. TYRA

Scout

Kansas

Map No. _____ Sec. 17 Twp. 20 R. 10WWell No. 2 1 Massman (mas #1)

Branine & Holl

Company

Contractor

SW NW NW

SECTION PLAT

990 Ft. from N. Line

_____ Ft. from S. Line

_____ Ft. from E. Line

330 Ft. from W. Line

Rice County

Location _____

Rig up _____

Drilling and Remarks:

abd 3331

DD 3342

S/ $\frac{1}{2}$ boph

1000 acid

S/ 14 goph

5 bwph

3350-59 TD

RECORD

Cased _____ in., _____ ft.

Sand _____

Gas _____

Oil _____

Total Depth 3359

PRODUCTION

1st 24 hrs. Nat. _____

1st 24 hrs. after shot _____

Gas _____ Cu. Ft.

Dry Hole _____

Abandoned _____

D & A

Date

JUL 19 1950

19

J. E. TYRA Scout

568C