


Rice

KANSAS

Section 18 Township 20 Range 10-W

Well No. #1 Burchart

Company J. H. Tatlock

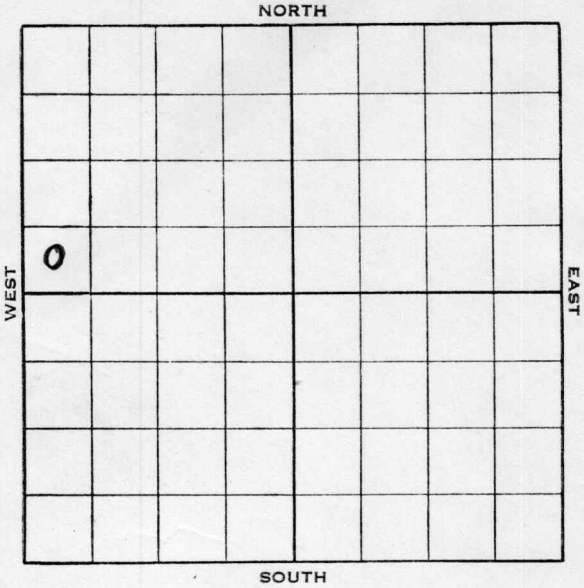

Rice

KANSAS

Map No. 46 Sec. 18 Twp. 20 R. 10WWell No. 1 BurchartJ. H. Tatlock

Company

Contractor

FIRST REPORT

SW NW

SECTION PLAT

0			

 Ft. from N. Line330 Ft. from S. Line Ft. from E. Line330 Ft. from W. LineLocation Rig up

Drilling and Remarks:

RUR

RECORD

Cased in., ft.Sand Gas Oil Total Depth

PRODUCTION

1st 24 hrs. Nat. 1st 24 hrs. after shot Gas Cu. Ft.Dry Hole Abandoned

Date

SEP 7 - 1938

19

ORVAL MANNSCHRECK

Scout

Rice

KANSAS

Map No. 46 Sec. 18 Twp. 20 R. 10WWell No. 1 BurchartJ. H. Tatlock

Company

Contractor

COMPLETED

SW NW

Ft. from N. Line

330

Ft. from S. Line

Ft. from E. Line

330

Ft. from W. Line

SECTION PLAT

0			

Location

Rig up

Drilling and Remarks:

RECORD

Cased 7 in., 3290 ft.Sand Arb 3290

Gas

Oil

Total Depth 3295

PRODUCTION

1st 24 hrs. Nat. _____

1st 24 hrs. after shot _____

Gas _____ Cu. Ft.

Dry Hole _____

Abandoned _____

POT 310
NAT

Date

OCT 12 1938

19

H. D. Hatfield

Scout