

KANSAS


Form 51-5M 5-37 Petrol

Rice

Section 18 Township 20 Range 10-W

Well No. 2 Hirsch

Company Gulf

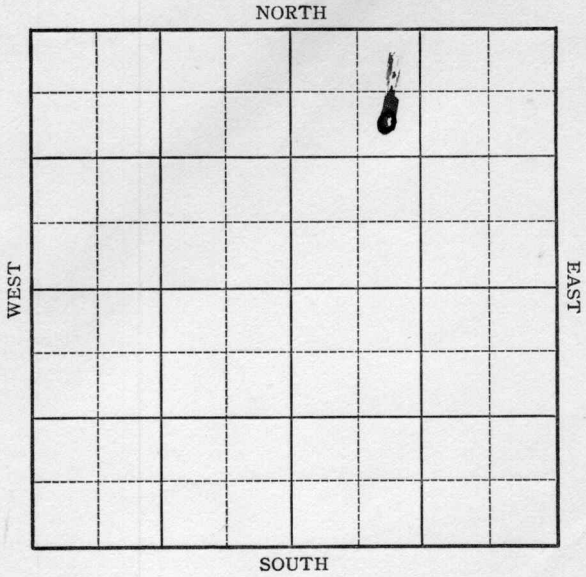

Map No. 46 Sec. 18 Twp. 20 R. 10W,Well No. 2 HirschGulf

Company

Contractor

FIRST REPORT

SE NW NE

990 Ft. from N. Line Ft. from S. Line Ft. from E. Line990 Ft. from W. Line

SECTION PLAT

		0	

Location Rig up

Drilling and Remarks:

BRR

RECORD

Cased in., ft.Sand Gas Oil Total Depth

PRODUCTION

1st 24 hrs. Nat. 1st 24 hrs. after shot Gas Cu. Ft.Dry Hole Abandoned

Date

DEC 29 1937 19 H. D. Hatfield Scout

Rice

KANSAS

Map No. _____ Sec. 18 Twp. 20 R. 10WWell No. 2 HirschGulf

Company _____

Contractor _____

COMPLETED

SE NW NE

990 Ft. from N. Line

_____ Ft. from S. Line

_____ Ft. from E. Line

990 Ft. from W. Line

SECTION PLAT

		0	

Location _____

Rig up _____

Drilling and Remarks:

5000 acid
POT 768

RECORD

Cased 6 in., 3308 ft.Sand Arb 3308

Gas _____

Oil _____

Total Depth 3328

PRODUCTION

1st 24 hrs. Nat. _____

1st 24 hrs. after shot _____

Gas _____ Cu. Ft.

Dry Hole _____

Abandoned _____

Date

FEB 2 1938

19

H. D. Hatfield Scout