Form 51-5M 5-37 Petrol


Rice

KANSAS

Section 18 Township 20 Range 10-W

Well No. 2 Mantel

Company Rose Spring Drlg.

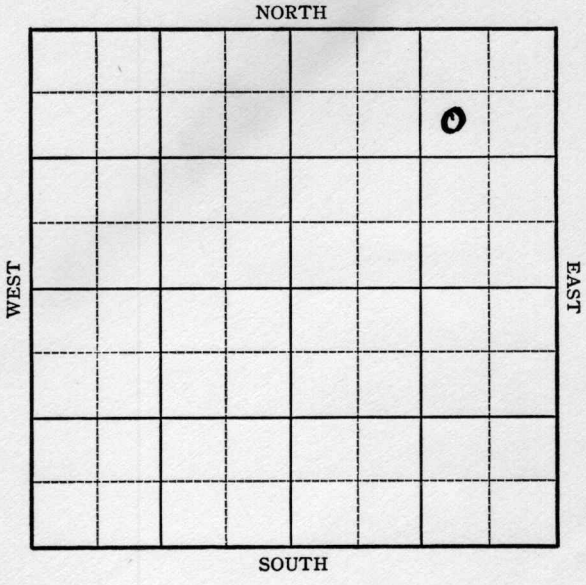

Form 252-A—5M—2-37—Palace KANSAS Rice

Sec. 18 Twp. 20 R. 10-W

Well No. #2 Mantel Farm


Rose Spring Drlg. Company

990 Ft. from N. Line

Ft. from S. Line

990 Ft. from E. Line

Ft. from W. Line

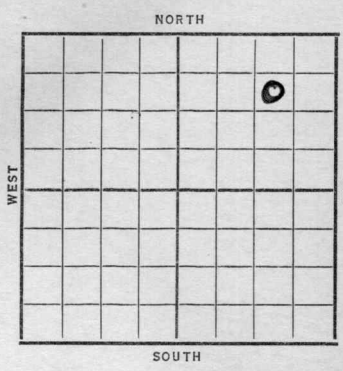

Elev. 1780

Date	REPORT
1937	
10/6	R U R
10/15	"
10/22	R. R.
10/29	"
11/5	12" @ 120'. WOC.
11/12	Drlg. 1750'.
11/19	Drlg. 2995'.
11/26	Sil. & 7" @ 3302'. Sat. in core
	RUST.
12/3	T.D. 3304'. 1700' oil 30 Min.
12/8	7" @ 3302'.
	Sil. 3302'.
	T.D. 3318'.
	Potential 1165 bbls., Nat.
	COMPLETED

Form 26—1M Bks.—2-29

Rice KANSAS

Map No. _____ Sec. 18 Twp. 20 R. 10W

Well No. 2 Mantel

Rose Spring Drlg Company

Contractor

FIRST REPORT

SW NE NE


990 Ft. from N. Line

_____ Ft. from S. Line

990 Ft. from E. Line

_____ Ft. from W. Line

SECTION PLAT

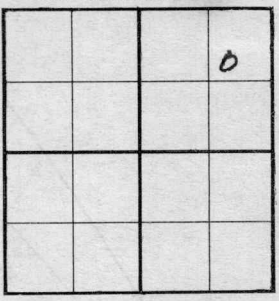

Location _____

Rig up _____

Drilling and Remarks:

RUR

RECORD

Cased _____ in., _____ ft.

Sand _____

Gas _____

Oil _____

Total Depth _____

PRODUCTION

1st 24 hrs. Nat. _____

1st 24 hrs. after shot _____

Gas _____ Cu. Ft.

Dry Hole _____

Abandoned _____

Date

OCT - 6 1937 19 _____

H. D. Hatfield Scout

Form 26—1M Bks.—2-29 Rice KANSAS

Map No. 46 Sec. 18 Twp. 20 R. 10W

Well No. 2 Mantel

Rose Spring Drlg. Company

Contractor

COMPLETED

SW NE NE


990 Ft. from N. Line

Ft. from S. Line

990 Ft. from E. Line

Ft. from W. Line

SECTION PLAT

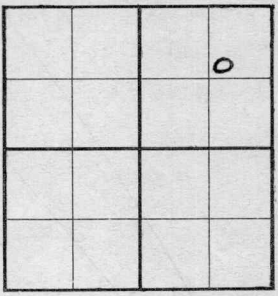

Location

Rig up

Drilling and Remarks:

POT- 1165
NAT

RECORD

Cased 7 in., 3302 ft.

Sand Sil 3302

Gas

Oil

Total Depth 3318

PRODUCTION

1st 24 hrs. Nat.

1st 24 hrs. after shot

Gas Cu. Ft.

Dry Hole

Abandoned

Date

DEC 8 - 1937

19

H. D. Hatfield Scout