


Section 18 Township 20 Range 10-W

Well No. #2 Burchardt

Company Fred Jones

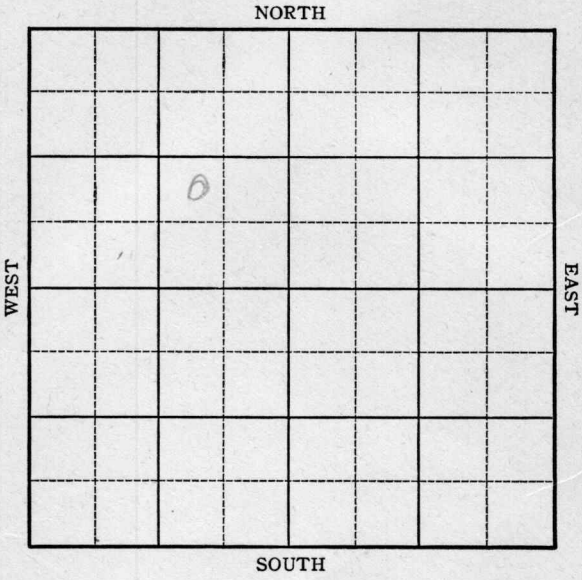

KANSAS

Sec. 18 Twp. 20 R. 10W

Well No. #2 Burchardt Farm

Fred Jones Company


Silica

\_\_\_\_\_ Ft. from N. Line

990 Ft. from S. Line

990 Ft. from E. Line

\_\_\_\_\_ Ft. from W. Line

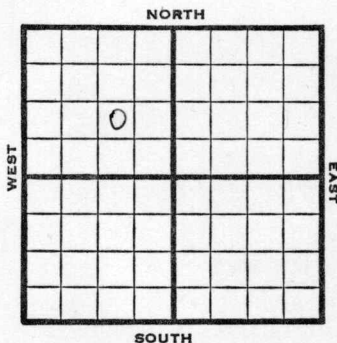

NW SE NW

1946 Elev. 1754' REPORT

1/16 8" @ 142  
Drlg. 2851'

1/24 Arb. 3280' T.D. 5" - 3280' RUST.  
1/31 T.D. 3286' Swab 10 oil per hr 10 hours.  
Show water. P.B. to 3285'

2/6 Arb. 3280  
5" @ 3280  
TD 3286'  
Pump 82 Pot.  
Grav. 41.7

COMPLETED



