


Rice

KANSAS

Section 18 Township 20 Range 10W

Well No. #3 Berscheit "B"

Company N C R A

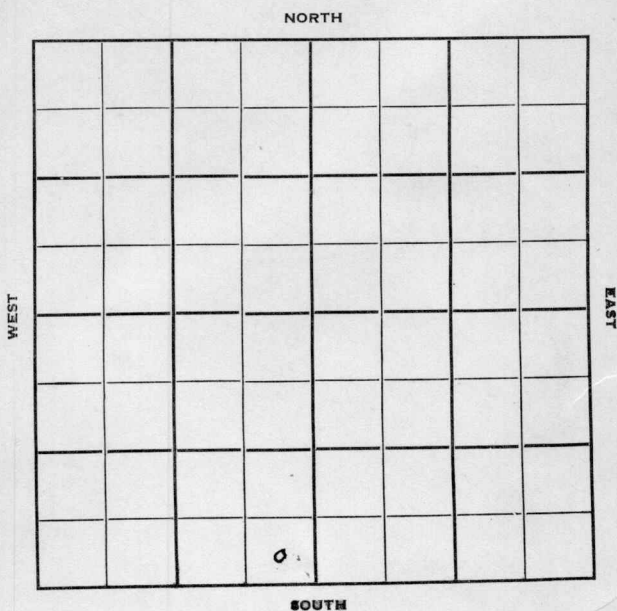

Rice

KANSAS

Sec. 18 Twp. 20 R. 10W

Well No. #3 Berscheit "B" Farm

N C R A

Company

Lindas Drlg. - Contr.

Contractor

Silica Pool

Ft. from N. Line

330'


Ft. from S. Line

330'

Ft. from E. Line

Ft. from W. Line

SE SE SW

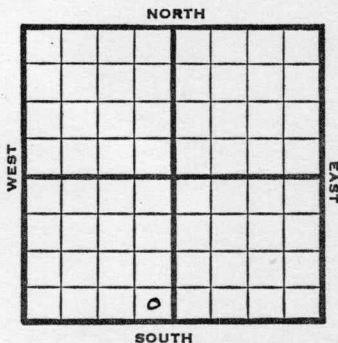

1950

Elev 1742'

REPORT

10/18

MIM

11/15

10" @ 178

Anhy 570

Heeb 2853

Br lime 2976

Lans 3011

DST 3083-91 opn 1 hr rec 660' gas
72' ocm

Arb 3281

DST 3282-90 opn 1 hr rec 15' mud

TD 3340

7" @ 3338

Granite 3879-80 TD

5000 A

Comp SWD well

TD 3880

Abandoned

ABANDONED

County Rice State Kansas

Sec. 18 (Blk.) 20 (Sur.) 10W Map No.

Operator NCRA

Well No. 3 Farm Berscheid "B"

Elev.	Location	SE	SE	SW
-------	----------	----	----	----

0

FIRST REPORT

330 Ft. From S Line SW

330 Ft. From E Line Quarter

1st. Report OCT 18 1950

Completion

Remarks

Lindas Drle. - Contr.

Spudding Date _____

Drlg. Data Silica Pool

M I M

J. E. TYRA

County Rice State KansasSec. 18 (Blk.
Twp.) 20 (Sur.
Rge.) 10W Map No.Operator N C R AWell No. 3 Farm Berscheidt "B"Elev. 1742 Location SE SE SW330 Ft. From S Line SW330 Ft. From E Line Quarter

1st. Report

Completion NOV 15 1950Remarks Silica PoolLindas - Contr.

Spudding Date

Drlg. Data SWD well TD 388010" @ 178 Anhy 570 Heeb. 2853Br. lime 2976 Lans. 3011 DST 3083-91open 1 hr. Rec. 660' gas 72' ocmArb. 3281 DST 3282-90 open 1 hr.Rec. 15' mud TD 3340 7" @ 3338Granite 3879-80 TD 5000 AComp. SWD well

J. E. TYRA