


Section 25 Township 31 Range 4 E

Well No. #1 Tanner "B"

Company Cities Service

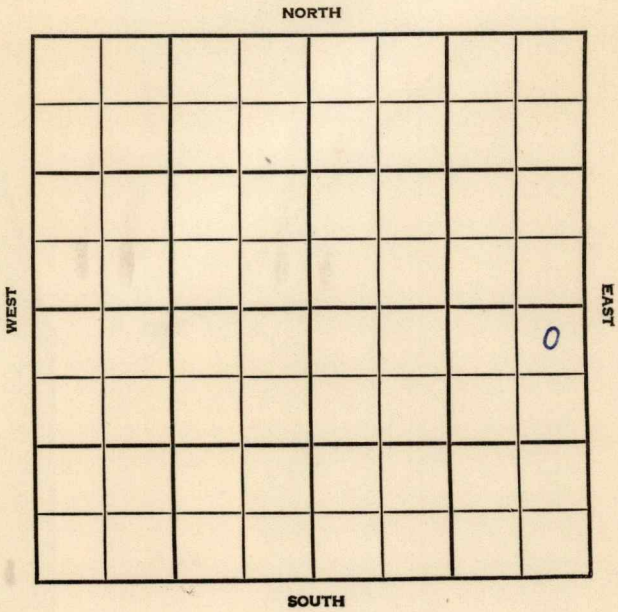

Cowley

KANSAS

SEC.

TWP.

R.

25

31

4E

WELL NO.

#1 Tanner "B"

FARM

COMPANY

Cities Service

CONTRACTOR

White & Ellis

Wilmot-Floral

NORTH


Ft. from N. Line

Ft. from S. Line

Ft. from E. Line

Ft. from W. Line

NE NE SE

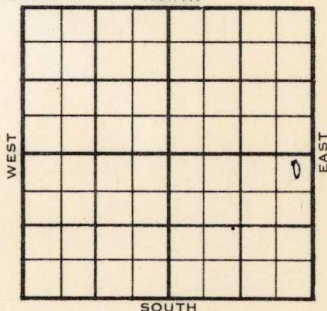

1956

ELEVATION

REPORT

2-15

Comm. 2-11-56

8" @ 160/125

Drlg. 1940

Layton 1874

County Cowley Elev. 1245
 Sec. 25 Twp. 31 Rge. 4E
 Company Cities Service
 Farm Name Tanner "B" No. 1

TOPS	DEPTH	LOG	DATUM	Loc. in Sec.
Asht.				NE NE SE
Top				
H.				
Tc.				
Dg.				
Bl.				
L. <u>187h</u>	<u>187h</u>	<u>57211</u>	<u>629</u>	
KE <u>124</u>	<u>2289</u>		<u>1044</u>	Seci.
KE <u>124</u>	<u>2387</u>		<u>1136</u>	
Co. <u>Castle</u>	<u>2875</u>		<u>1030</u>	Conte
C.				White & Bluffs
M.	<u>2980</u>		<u>1735</u>	
M. <u>Dale</u>	<u>3006</u>		<u>1761</u>	Pool
K.				Wilnot-Floral
Mo.				
Mo.				
V.				
S.				
S.				
A.				
R.				
PC.				
S.				
TD	<u>3028</u>			

ABANDONED

Date Comm. 2-11-56 FEB 22 1956
 8" @ 160/125 drlg. 1940 FEB 22 '56

DST 2296-2337 1hr rec 560'
M & GCSW BHP 580/20 DST
2929-60 1hr rec 6' Md BHP
12/20

R & A

County Cowley Elev. _____
 Sec. 25 Twp. 31 Rge. 4E
 Company Cities Service
 Farm Name Tanner "B" No. 1

TOPS	DEPTH	LOG	DATUM
Anh.			
Tp.			
H.			
Tr.			
Dg.			
Bl.			
L.			
K.C.			
B.K.C.			
Ce.			
C.			
M.			
M.			
K.			
Mz.			
Mq.			
V.			
S.			
S.			
A.			
R.			
PE.			
G.			
T.D.			

Loc. in Sec. _____

NE NE SE

Geol. _____

Contr. _____

White & Ellie

Pool _____

Wilmot-Floral

FIRST REPORT

FEB 15 '56

Date Comm. _____

2-11-56

8" @ 160/125 drlg. 1940