

KANSAS

Form 51-5M-7-39-Palace


Cowley

Section 28 Township 31 Range 4-E

Well No. #2 Curfman

Company Arthur Brewer

NORTH Hittle Pool

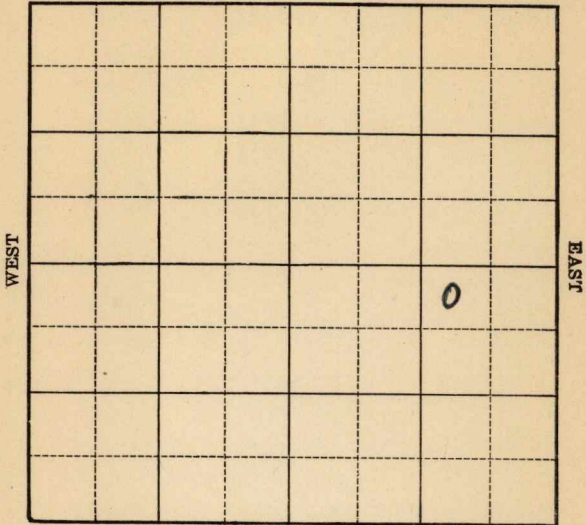

SOUTH

Map No. 2 Sec. 28 Twp. 31 R. 4E

Well No. 2 Curfman

Arthur Brewer Company

Contractor

FIRST REPORT

SECTION PLAT

NW NE SE
330 Ft. from N. Line
 _____ Ft. from S. Line
990 Ft. from E. Line
 _____ Ft. from W. Line

			0

HITTLE POOL

Location _____

Rig up _____

Drilling and Remarks:

15" @ 480
 12" @ 1140
 Dr1g. 1245

RECORD

Cased _____ in., _____ ft.
 Sand _____
 Gas _____
 Oil _____
 Total Depth _____

PRODUCTION

1st 24 hrs. Nat. _____
 1st 24 hrs. after shot _____
 Gas _____ Cu. Ft.
 Dry Hole _____
 Abandoned _____

Date

MAR 20 1919

S. J. LEWIS Scout

Map No. 2 Sec. 28 Twp. 31 R. 4E

Well No. 2 Curfman

Arthur Brewer Company

Contractor

ABANDONED

NW NE SE

330 Ft. from N. Line

_____ Ft. from S. Line

990 Ft. from E. Line

_____ Ft. from W. Line

HITTLE POOL

SECTION PLAT

			6.

Location _____

Rig up _____

Drilling and Remarks:

CR 83400

Water

RECORD

Cased _____ in., _____ ft.

Sand _____

Gas _____

Oil _____

Total Depth 3407

PRODUCTION

1st 24 hrs. Nat. _____

1st 24 hrs. after shot _____

Gas _____ Cu. Ft.

Dry Hole _____

Abandoned _____

Date

19 _____

S. J. LEWIS Scout