


Section 28 Township 31 Range 4-E

Well No. 3 Lewis

Company Arthur Brewer

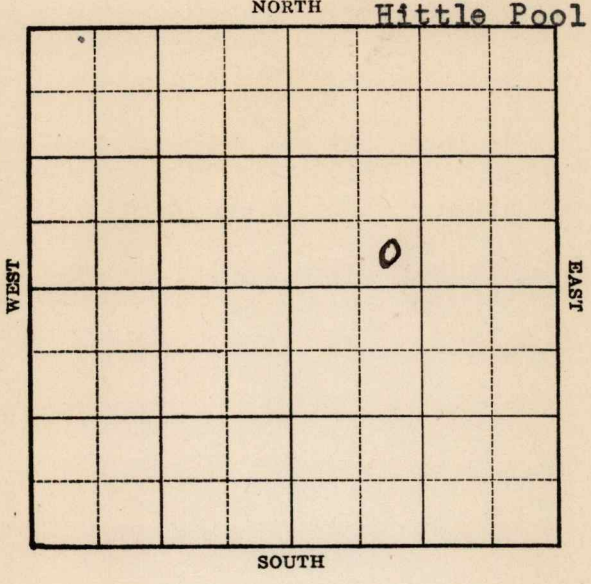



1939  
5/31

Arb. 3341'

5" - 3327'

T.D. 3345'

Pump 637 bbls. in 8 hours.

Potential 1912 bbls.

**COMPLETED**



Map No. 2 Sec. 28 Twp. 31 R. 4E

Well No. 3 Lewis

Arthur Brewer Company

Contractor

COMPLETED

SECTION PLAT

SE SW NE

\_\_\_\_\_ Ft. from N. Line

330 Ft. from S. Line

\_\_\_\_\_ Ft. from E. Line

990 Ft. from W. Line


HITTLE POOL

Location \_\_\_\_\_

Rig up \_\_\_\_\_

Drilling and Remarks:

*Cor & 3341  
5" @ 3327*

*Pump. 637 in 8 hrs*

*P & 1912*

RECORD

Cased \_\_\_\_\_ in., \_\_\_\_\_ ft.

Sand \_\_\_\_\_

Gas \_\_\_\_\_

Oil \_\_\_\_\_

Total Depth 3345

PRODUCTION

1st 24 hrs. Nat. \_\_\_\_\_

1st 24 hrs. after shot \_\_\_\_\_

Gas \_\_\_\_\_ Cu. Ft.

Dry Hole \_\_\_\_\_

Abandoned \_\_\_\_\_

Date

MAY 31 1939

19

S. J. LEWIS

Scout