


Section 28 Township 31 Range 4-E

Well No. #2 "A" Hittle (Twin to #2)

Company Trees

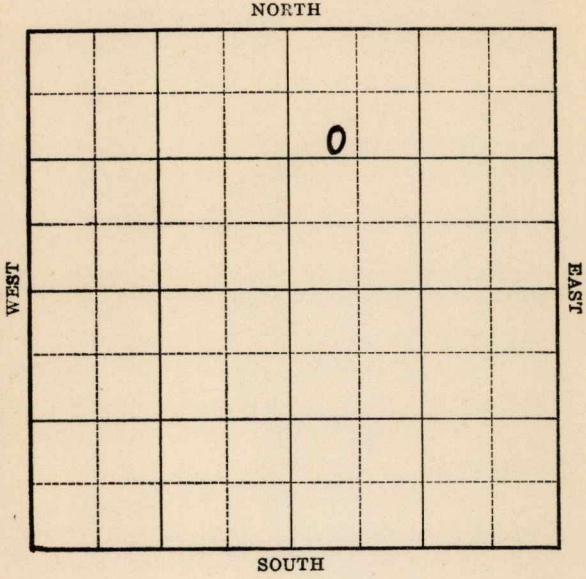

Sec. 28 Twp. 31 R. 4-E

Well No. #2 "A" Hittle (Twin to #2) Farm

Trees Company

(Hittle)


1090 Ft. from N. Line

_____ Ft. from S. Line

_____ Ft. from E. Line

300 Ft. from W. Line

Elev. 1248

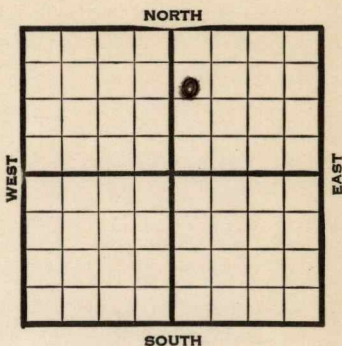

1939	REPORT
7/19	Rotary.
7/27	10" - 138' Drlg. 1660'
8/3	Miss. 3017' Drlg. 3206'
8/10	Arb. 3332' 7" - 3320'
	T.D. 3346' Flow 40 bbls. per hour.
8/16	Arb. 3332'
	7" - 3320'
	T.D. 3346'
	Bottom hole pressure bomb
	potential 2275 bbls.
	COMPLETED

Map No. 2 Sec. 28 Twp. 31 R. 4E

Well No. 2 "A" Hittle (Twin to #2)

Trees

Company _____

Contractor _____

FIRST REPORT

SECTION PLAT

SW NW NE

1090 Ft. from N. Line

_____ Ft. from S. Line

_____ Ft. from E. Line

300 Ft. from W. Line

		o	

HITTLE POOL

Location _____

Rig up _____

Drilling and Remarks:

Rotary

RECORD

Cased _____ in., _____ ft.

Sand _____

Gas _____

Oil _____

Total Depth _____

PRODUCTION

1st 24 hrs. Nat. _____

1st 24 hrs. after shot _____

Gas _____ Cu. Ft.

Dry Hole _____

Abandoned _____

Date

JUL 19 1939

19

S. J. LEWIS

Scout

Cowley

Map No. 2 Sec. 28 Twp. 31 R. 4E

Well No. 2-A Hittle (Twin #2)

Trees

Company _____

Contractor _____

COMPLETED

SECTION PLAT

SW NW NE

1090 Ft. from N. Line

_____ Ft. from S. Line

_____ Ft. from E. Line

300 Ft. from W. Line

		0	

HITTLE POOL

Location _____

Rig up _____

Drilling and Remarks:

As 83382.

7" @ 3320

Bottom Hole Pressure

Box 8

2275

RECORD

Cased _____ in., _____ ft.

Sand _____

Gas _____

Oil _____

Total Depth 3346

PRODUCTION

1st 24 hrs. Nat. _____

1st 24 hrs. after shot _____

Gas _____ Cu. Ft.

Dry Hole _____

Abandoned _____

Date

AUG 16 1939 19

S. J. LEWIS Scout