


Map No. KANSAS Sec. 20 Twp. 20 R. 10^W

Well No. 1 Specht Farm
Empire Oil Company

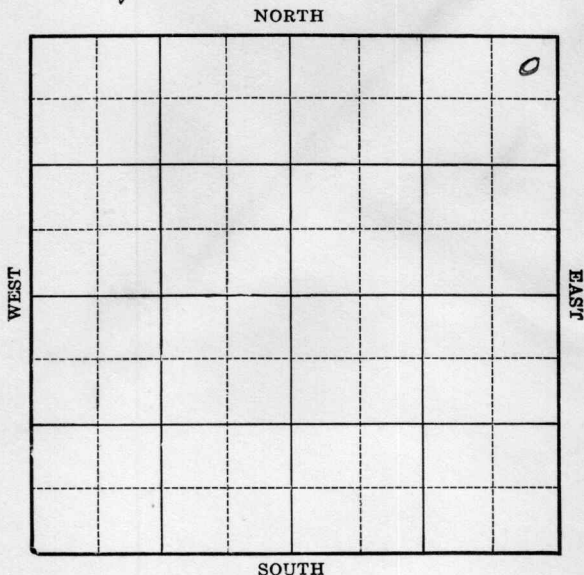

Location _____

Drilling Remarks _____

RECORD

Cased _____ in. _____ ft.

Sand _____

Gas _____

Oil _____

Total Depth _____

Rig Up _____

Drilling Remarks _____

PRODUCTION

1st 24 hrs. Nat. _____

1st 24 hrs. after shot _____

Gas _____ cu. ft.

Dry Hole _____

Abandoned _____

Rice


Map No. KANSAS Sec. 20 Twp 20 R. 10W
Well No. 1 Specht Farm
Empire oil Company

330 Ft. from N. Line

_____ Ft. from S. Line

330 Ft. from E. Line

_____ Ft. from W. Line

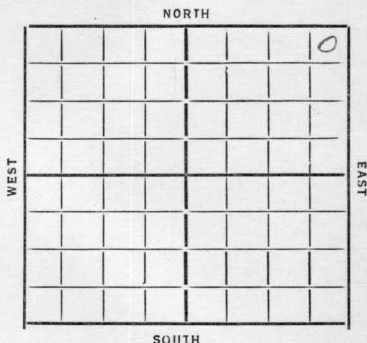

Date 1934

REPORT

8/15 location
8/23 Bldg.
8/30 Rign
9/6 20" 64 anhydrite 405
15 1/2" 408 WOC
9/13 Bldg 705 15" 450
9/20 " 1565 12" 1254
9/27 " 1900 10" 1869
10/4 2240 W.C. 8"
10/11 8" 2400 T.D. 2440 W.C.
10/18 HFW 2590-2600 Bldg 2825
8" 2618
10/25 K.C.L. 3041 Oil 3101-04
T.D. 3106 600' oil 1000 acid
11/1 Pump 194 Bldg oil 13 hrs.
11/8 — 11/15 — 11/22 —
11/28 Bldg 3230
12/6 Siliceous 3344 T.D. 3346
500' oil 1/2 hr. 6" 3344 WOC
12/12 Siliceous 3344 T.D. 3346
297 oil 71 Water.

COMPLETED

KANSAS

Map No. 46 Sec. 20 Twp. 20 R. 10^W

Well No. 1- Specht

Empire Oil

Company

Contractor

FIRST REPORTS

SECTION PLAT

			0

330 Ft. from N. Line

_____ Ft. from S. Line

330 Ft. from E. Line

_____ Ft. from W. Line

Location ✓

Rig up _____

Drilling and Remarks:

RECORD

Cased _____ in., _____ ft.

Sand _____

Gas _____

Oil _____

Total Depth _____

PRODUCTION

1st 24 hrs. Nat. _____

1st 24 hrs. after shot _____

Gas _____ Cu. Ft.

Dry Hole _____

Abandoned _____

Date

8-15-34 19

ORVAL MANNSCHRECK

Scout

Map No. 46 Sec. 20 Twp. 20 R. 10 WWell No. 1- SpurtEmpire oil Company

Contractor

COMPLETED

SECTION PLAT

330 Ft. from N. Line

Ft. from S. Line

330 Ft. from E. Line

Ft. from W. Line

			0

Location

Rig up

Drilling and Remarks:

297 oil
71 water

RECORD

Cased _____ in., _____ ft.

Sand siliceous 3344

Gas _____

Oil _____

Total Depth 3346

PRODUCTION

1st 24 hrs. Nat. _____

1st 24 hrs. after shot _____

Gas _____ Cu. Ft.

Dry Hole _____

Abandoned _____

Date

12-12-31 192

ORVAL MANNSCHRECK

Scout